

**SURVEY &  
REMONUMENTATION**

SEP 08 1998

**LAND CORNER RECORDATION CERTIFICATE**  
Filing Requirement of Act 74, Mich. P.A. 1970

Register's Office }  
Gogebic County } ss.

For corners in

Gogebic SECTION  
(County)

Located in:

Corner Code #

- |                                    |                             |       |
|------------------------------------|-----------------------------|-------|
| 1. Public Land Survey              | T <u>46</u> N R <u>43</u> W | G-5   |
|                                    | T ___ R ___                 | _____ |
|                                    | T ___ R ___                 | _____ |
|                                    | T ___ R ___                 | _____ |
| 2. Property Controlling in Section | S ___ T ___ R ___           | _____ |
|                                    | S ___ T ___ R ___           | _____ |
| 3. Miscellaneous Property in Sec.  | S ___ T ___ R ___           | _____ |
|                                    | S ___ T ___ R ___           | _____ |

Received for record the  
14<sup>th</sup> day of MAY  
A. D. 1998 at 3:10 o'clock  
P m., and recorded in  
Liber 6 of CORNERS  
page 345  
Ramona Collins, Deputy  
Register of Deeds

Register of Deeds Stamp & File Number

4. Lot No. \_\_\_\_\_, Recorded Plat \_\_\_\_\_  
5. Private Claims \_\_\_\_\_

Section Corner, Sections 9, 10, 15 & 16; T46N, R43W

I, John P. Goss, in a field survey on May 7, 1998 do hereby state that under requirements of P.A. 74, Michigan P.A. of 1970, the corner points mentioned in lines 1 and 2 above were in conformance with regulations and rules therefore as required in the current manual of survey instructions of the United States Department of the Interior, Bureau of Land Management or by a decree of a Court of Law and/or that the corner points mentioned in lines 3, 4 and 5 above were in conformance with the rules of the Michigan Board of Land Surveyors or by a Decree of a Court of Law; established, re-established, monumented, recovered, found as expressed below:

NOTE: Not more than 2 corners, all in the same town and range, may be recorded on this certificate.

A	B	C	D	E	F	G	H	I	J	K	L	M
1												
2	6	5	4	3	2	1						
3												
4	7	8	9	10	11	12						
5												
6	18	17	16	15	14	13						
7												
8	19	20	21	22	23	24						
9												
10	30	29	28	27	26	25						
11												
12	31	32	33	34	35	36						
13												

A. Description of original monument and accessories and/or subsequent restoration:

Corner established by Austin Burt, on August 30, 1851.

Original bearing trees: Spruce 10" S 12° W 17 links (11.22')  
Cedar 7" N 31° E 9 links (5.94')

Richard L. Drahn, RLS, on June 19, 1986, found corner position marked by a 6" long portion of the original corner post under 10" of swamp litter at record bearing and distance from the remains of the two original bearing trees. He set a 3/4" dia. by 7' long solid aluminum rod monument with 3/4" aluminum cap stamped to indicated the corner position. He established the following reference objects:  
8" Tamarack N 07° W 20.61' 10" Cedar S 77° E 15.14'

B. Description of corner evidence found and/or method applied in restoring or reestablishing corner:

8" Tamarack S 59° W 10.83' 6' Steel sign post N 46° E 1.6'

He recorded said corner in Liber 3, page 11 of Land Corners for Gogebic County.

Found Richard L. Drahn corner monument and witnesses.

I updated the corner monument and accessories as noted below to state and county specification.

Act 74 research on file.

**PEER GROUP APPROVAL**  
Richard L. Drahn 5/13/98  
COUNTY REGISTER

C. Description of monument for corner and accessories established to perpetuate locating the position of the corner:


From the 3/4" dia. by 7' long aluminum monument with 3/4" aluminum cap which reads: T.46 N., R.43 W.; S-9, S-10, S-15, S-16; 1986; R.L.S. 21564: from which I established the following existing and new reference objects.

- |                    |         |                |
|--------------------|---------|----------------|
| 11" Tamarack       | N 07° W | 20.61'         |
| 11" Cedar          | S 77° E | 15.14'         |
| 10" Tamarack       | S 59° W | 10.83'         |
| 8" Cedar           | N 36° E | 19.95'         |
| 6' steel sign post | N 46° E | 1.6' (to face) |

( All measurement taken to nail in side of tree )

Signed by John P. Goss  
Surveyor's Michigan License No. 23509

Date May 7, 1998

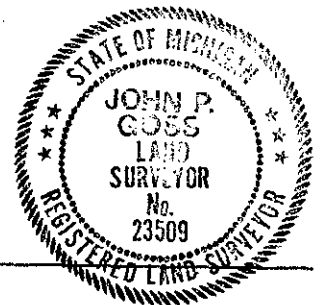

Fed. No. J-13