

**SURVEY & REMONUMENTATION**

OCT 03 1996

**COMMISSION LAND CORNER RECORDATION CERTIFICATE**  
**Filing Requirement of Act 74, Mich. P.A. 1970**

For corners in Gogebic (County) Located In: \_\_\_\_\_ Corner Code # \_\_\_\_\_

1. Public Land Survey	T <u>46N</u> R <u>R43W</u>	<u>G-7</u>
	T _____ R _____	_____
	T _____ R _____	_____
	T _____ R _____	_____
2. Property Controlling in Section	S _____ T _____ R _____	_____
	S _____ T _____ R _____	_____
3. Miscellaneous Property in Section	S _____ T _____ R _____	_____
	S _____ T _____ R _____	_____
4. Lot No. _____, Recorded Plat _____		
5. Private Claims _____		


Register's Office }  
 Gogebic County } ss.

Received for record the 23<sup>RD</sup> day of FEB A. D. 1996 at 1:35 o'clock P m., and recorded in Liber 5 of CORNERS on page 316.  
Ramona Collins Deputy  
 Register of Deeds

Register of Deeds Stamp & File Number

Section corner common to Sections 15, 16, 21 and 22, T46N, R43W.

I, John R. Garske, in a field survey on November 9, 1995, do hereby certify that under requirements of P.A. 74, Michigan P.A. of 1970, the corner points mentioned in lines 1 and 2 above were in conformance with regulations and rules therefore as required in the current manual of survey instructions of the United States Department of the Interior, Bureau of Land Management or by a decree of a Court of Law and/or that the corner points mentioned in lines 3, 4 and 5 above were in conformance with the rules of the Michigan Board of Professional Surveyors or by a Decree of a Court of Law; established, re-established, monumented, re-monumented, recovered, found as expressed below:

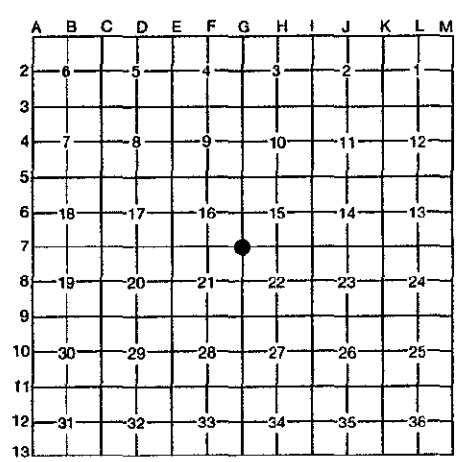

**NOTE: Not more than 4 corners, all in the same town and range, may be recorded on this certificate.**

**A. Description of original monument and accessories and/or subsequent restoration:**

- On July 17, 1851, Austin Burt, U.S.D.S., set the corner post from which a 10" Y. birch - S43°W - 28 links; 7" Y. birch - N48°E - 22 links.
- On June 25, 1986, U.S.F.S. Surveyor, Richard L. Drahn, RLS 21564, found an old 1 1/4" iron pipe marking the corner location which has been used since the turn of the century. Over the top of the pipe Drahn set a 2" I.D. x 30" aluminum monument with a 3 1/4" aluminum cap stamped to read: T46N-R43W, S-15, S-16, S-21, S-22, 1986, RLS 21564. He also set B.T.'s as follows:  
 4" cedar - N24°W - 30.97 feet      5" R. maple - S50°W - 41.34 feet  
 5" B. ash - N79°E - 35.99 feet      6' steel sign post - S02°W - 4.2 feet

Corners recorded in Liber 3 of land corners Page 12.

**B. Description of corner evidence found and/or method applied in restoring or reestablishing corner:**

I found the monument and accessories set by Drahn as described above and accepted same.


Act 74 research on file at County Register of Deeds office.

**C. Description of monument for corner and accessories established to perpetuate locating the position of the corner:**

I used the monument set by Drahn at the corner location checked and/or established the following bearing trees and reference objects:

- 5" ash - N83°E - 35.99 feet (existing)
- 6" R. maple - S52°W - 41.34 feet (existing)
- 4" balsam - N01°W - 11.62 feet (new)
- 6' steel sign post - S06°W - 4.22 feet

PEER GROUP APPROVED  
Richard L. Drahn 12/14/95  
 COUNTY REPRESENTATIVE

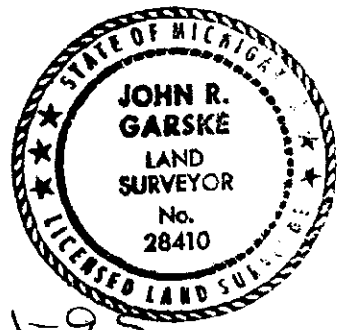

Signed by John R. Garske Date 12-11-95  
 Surveyor's Michigan License No. 28410