

SURVEY & REMONUMENTATION

SEP 08 1998

SECTION

LAND CORNER RECORDATION CERTIFICATE
Filing Requirement of Act 74, Mich. P.A. 1970

Register's Office }
Gogebic County } ss.

Received for record the
18th day of JUNE
A. D. 1998 at 1:15 o'clock
P m., and recorded in
Liber 6 of CORNERS
on page 406
Ramona Collins, Deputy
Register of Deeds

Register of Deeds Stamp & File Number


For corners in	Located In:	Corner Code #
<u>Gogebic</u> (County)		
1. Public Land Survey	<u>T46NR 43W</u>	<u>G-8</u>
	T <u> </u> R <u> </u>	<u> </u>
	T <u> </u> R <u> </u>	<u> </u>
	T <u> </u> R <u> </u>	<u> </u>
2. Property Controlling in Section	S <u> </u> T <u> </u> R <u> </u>	<u> </u>
	S <u> </u> T <u> </u> R <u> </u>	<u> </u>
3. Miscellaneous Property in Sec.	S <u> </u> T <u> </u> R <u> </u>	<u> </u>
	S <u> </u> T <u> </u> R <u> </u>	<u> </u>

4. Lot No. _____, Recorded Plat _____
5. Private Claims _____

Quarter Corner, Section 21 & 22, T.46 N., R.43 W.

I, John P. Goss, in a field survey on May 27, 1998 do hereby state that under requirements of P.A. 74, Michigan P.A. of 1970, the corner points mentioned in lines 1 and 2 above were in conformance with regulations and rules therefore as required in the current manual of survey instructions of the United States Department of the Interior, Bureau of Land Management or by a decree of a Court of Law and/or that the corner points mentioned in lines 3, 4 and 5 above were in conformance with the rules of the Michigan Board of Land Surveyors or by a Decree of a Court of Law; established, re-established, monumented, recovered, found as expressed below:

NOTE: Not more than 2 corners, all in the same town and range, may be recorded on this certificate.

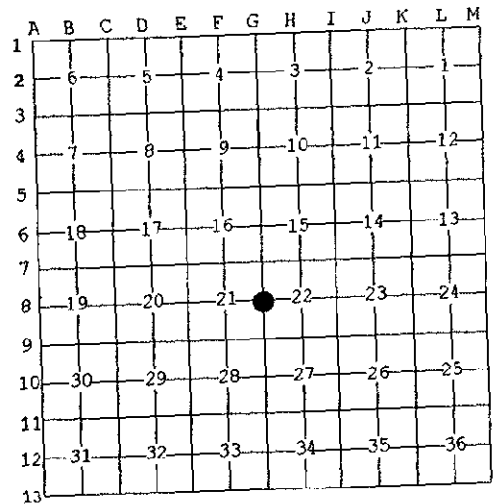

A. Description of original monument and accessories and/or subsequent restoration:

Corner established by Austin Burt, on August 28, 1851.
Original bearing trees: Hemlock 16" S 57° E 21 links (13.86')
Hemlock 20" N 80° W 40 links (26.40')

Robert A. Mick, R.L.S. 16936, on February 16, 1987, re-established corner position by single proportionate measure on a stright line midway between the Southeast and Northeast Corner of Section 21. He set a 2" I.D. aluminum monument with 3/4" Magnetized aluminum cap, stamped to indicated corner position. He established the following reference objects:
12" Cedar - N 22° W - 20.82'; 14" Yellow Birch - S 58° E - 16.47'

B. Description of corner evidence found and/or method applied in restoring or reestablishing corner:

4" Red Maple - S 42° W - 13.01'; Iron sign post
He recorded said corner in Liber 3, page 14 of Land Corners for Gogebic County.
No original evidence found.

Found Robert A. Mick, monument and witnesses.

I updated the monument and accessories as noted below to state and county specification.

Act 74 research on file.

DEED GROUP APPROVED
Richard L. Decker 6/10/98
COUNTY REGISTER

C. Description of monument for corner and accessories established to perpetuate locating the position of the corner:

From the found 2" I.D. aluminum monument with 3/4" magnetized aluminum cap, stamped to read: T.46 N., R.43 W.; 1/4; S-21, S-22; 1987; R.L.S. 16936, from which I established existing and new reference objects:

14" Cedar	N 22° W	21.74'
15" Yellow Birch	S 76° E	16.44'
7" Red Maple	S 42° W	13.01'
8" Maple	N 58° E	4.48'
Iron sign post	West	0.90' to face

(All measurement taken to nail in side of tree)

Signed by John P. Goss
Surveyor's Michigan License No. 23509

Date May 27, 1998

USFS No. P-13

