MAR 02 2000

SECTION

# LAND CORNER RECORDATION CERTIFICATE

**Filing Requirement of Act 74, Mich. P.A. 1970**

Register's Office } ss.
Gogebic County }

Received for record the 12TH day of MAY A. D. 19 99 at 10:55 o'clock A m., and recorded in Liber 7 of CORNERS on page 113

Ramona Collins Deputy
Register of Deeds

Register of Deeds Stamp & File Number

For corners in

Gogebic (County)

| | Located In: | Corner Code ## |
|---|---|---|
| 1. Public Land Survey | T 46N R 43W | H-7 |
| | T ___ R ___ | |
| | T ___ R ___ | |
| | T ___ R ___ | |
| 2. Property Controlling | S ___ T ___ R ___ | |
| in Section | S ___ T ___ R ___ | |
| 3. Miscellaneous | S ___ T ___ R ___ | |
| Property In Sec. | S ___ T ___ R ___ | |

4. Lot No. _____ , Recorded Plat _____
5. Private Claims _____

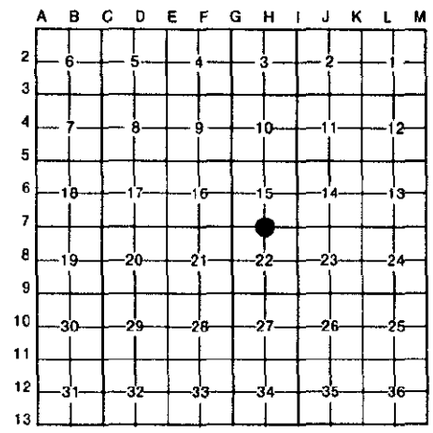


Quarter Corner 15 & 22; T.46 N., R.43 W.

I, Richard L. Drahn in a field survey on April 8, 19 99, do hereby certify that under requirements of P.A. 74, Michigan P.A. of 1970, the corner points mentioned in lines 1 and 2 above were in conformance with regulations and rules therefore as required in the current manual of survey instructions of the United States Department of the Interior, Bureau of Land Management or by a decree of a Court of Law and/or that the corner points mentioned in lines 3, 4 and 5 above were in conformance with the rules of the Michigan Board of Land Surveyors or by a Decree of a Court of Law; established, re-established, monumented, re-monumented, recovered, found as expressed below:

**NOTE: Not more than 4 corners, all in the same town and range, may be recorded on this certificate.**

A. Description of original monument and accessories and/or subsequent restoration:

Corner established by Austin Burt on 7/17/1851. Original B.T.s --- Sugar 6" S.33 W. 42 links (27.72') --- Y. Birch 10" N.34 E. 14 links (9.24') ---

Corner restored by Richard L. Drahn, RLS 21564, on10/30/84 from the remains of the two original B.T.s and from line trees east and west. He set a 2"X36" iron pipe with a 3" brass cap, stamped to indicate the corner and the following new B.T.s: --- 9" Y. Birch N.57 W. 31.33' --- 9" Sugar Maple N.08 E. 20.28' --- 16" Hemlock N.85 E. 6.23'--- 5' steel rail S.63 E. 1.6' ---

Corner recorded in Gogebic County Liber 2, Page 643 on 12/10/84.

B. Description of corner evidence found and/or method applied in restoring or reestablishing corner:

Recovered the monument as described and the bearing trees as follows:

| | | | | |
|---|---|---|---|---|
| 10" | Yellow Birch | N.56 W. | 31.28' | (new nail) |
| 10" | Sugar Maple | N.12 E. | 20.28' | (new nail) |
| 19" | Hemlock | N.87 E. | 6.27' | (new nail) |

Corner research on file with Gogebic County records.

Only fragments of Y. Birch bark and roots remain from the original B.T.

C. Description of monument for corner and accessories established to perpetuate locating the position of the corner:

New bearing tree referenced:

| | | | |
|---|---|---|---|
| 5" | Red Maple | S.16 W. | 24.34' |

PEER GROUP ENGINEERING
Richard L. Drahn 5/11/99
COUNTY REGISTRATION

STATE OF MICHIGAN
RICHARD L. DRAHN LAND SURVEYOR No. 21564
REGISTERED LAND SURVEYOR

Signed by Richard L. Drahn Date April 11, 1999

Surveyor's Michigan License No. 21564

USFS N-15

FORM APPROVED BY MICHIGAN STATE BOARD OF LAND SURVEYORS, JAN. 28, 1971
REVISED MAY 14, 1975
REVISED JAN., 1983