

MAR 02 2000

SECTION

LAND CORNER RECORDATION CERTIFICATE
Filing Requirement of Act 74, Mich. P.A. 1970

Register's Office } ss.
Gogebic County }

Received for record the
12TH day of MAY
A. D. 1999 at 10:50 o'clock
A m., and recorded in
Liber 7 of CORNERS
on page 115
Romana Collins, Deputy
Register of Deeds

For corners in

<u>Gogebic</u> (County)	Located in:	Corner Code #
1. Public Land Survey	T46NR 43W	H-13
	T R	
	T R	
2. Property Controlling in Section	T45NR 43W	H-1
	S T R	
	S T R	
3. Miscellaneous Property in Sec.	S T R	
	S T R	

Register of Deeds Stamp & File Number

4. Lot No. _____, Recorded Plat _____
5. Private Claims _____

Quarter Corner 34 & 3, T.45-46 N., R.43 W.

Richard L. Drahn in a field survey on April 26th 99 do hereby state that under requirements of P.A. 74, Michigan P.A. of 1970, the corner points mentioned in lines 1 and 2 above were in conformance with regulations and rules therefore as required in the current manual of survey instructions of the United States Department of the Interior, Bureau of Land Management or by a decree of a Court of Law and/or that the corner points mentioned in lines 3, 4 and 5 above were in conformance with the rules of the Michigan Board of Land Surveyors or by a Decree of a Court of Law; established, re-established, monumented, recovered, found as expressed below:

NOTE: Not more than 2 corners, all in the same town and range, may be recorded on this certificate.

	A	B	C	D	E	F	G	H	I	J	K	L	M
1													
2	6		5		4		3		2		1		
3													
4	7		8		9		10		11		12		
5													
6	18		17		16		15		14		13		
7													
8	19		20		21		22		23		24		
9													
10	30		29		28		27		26		25		
11													
12	31		32		33		34		35		36		
13													

A. Description of original monument and accessories and/or subsequent restoration:

Corner established by Austin Burt on 8/5/1847. Original B.T.s --- Spruce 10" N.81 E. 11 links (7.26') --- Spruce 10" N.61 W. 23 links (15.18') ---
Corner incorrectly monumented by Donald D. Lappala, RLS 12585 on 10/6/69. Ref. USFS Liber, Page A-15, dated 5/27/70.

Corner repositioned by C & NW Railroad plans (circa 1900) by Richard L. Drahn, RLS 21564 on 6/18/92. With Mr. Lappala's permission his 2" X5' iron pipe monument with a 3" stamped brass cap was re-positioned and re-stamped and the following new B.T.s were established.--- 10" White Pine

B. Description of corner evidence found and/or method applied in restoring or reestablishing corner:

N.31 W. 32.34' --- 5" Black Spruce N.61 E. 10.54' --- 4" Black Spruce S.12 E. 8.64' --- 4"X4"X7' Cedar sign post N.16 W. 3.20' ---

Corner recorded in Gogebic County Liber 4, Page 176 on 10/8/92.

Recovered the monument as described and the bearing trees as follows:

10"	White Pine	N.34 W.	32.32'
5"	Black Spruce	S.13 E.	8.63'
5"	Black Spruce	N.58 E.	10.52'
4"X4"X7'	Cedar sign post	N.15 W.	3.10'

No evidence of the original corner or B.T.s remain


C. Description of monument for corner and accessories established to perpetuate locating the position of the corner:

Corner research on file with Gogebic County records.

New bearing object referenced:

6' Steel sign rail S.73 E. 2.23'

Richard L. Drahn 5/11/99
Surveyor

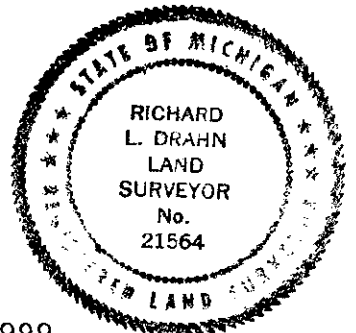

Signed by Richard L. Drahn
Surveyor's Michigan License No. 21564

Date May 2, 1999

USFS Z-15