

MAR 02 2000

SECTION

LAND CORNER RECORDATION CERTIFICATE

Filing Requirement of Act 74, Mich. P.A. 1970

For corners in

Gogebic (County) Located In: Corner Code #

1. Public Land Survey T 46N R 43W I-7
 T ___ R ___
 T ___ R ___
 T ___ R ___

2. Property Controlling in Section S ___ T ___ R ___
 S ___ T ___ R ___

3. Miscellaneous Property in Sec. S ___ T ___ R ___
 S ___ T ___ R ___

Register's Office }
Gogebic County } sa.


Received for record the
12TH day of MAY
 A. D. 1999 at 10.50 o'clock
A m., and recorded in
 Liber 7 of CORNERS
 on page 118
Ramona Collins Deputy
 Register of Deeds

Register of Deeds Stamp & File Number

4. Lot No. _____, Recorded Plat _____
 5. Private Claims _____

Section Corner 14, 15, 22 & 23; T.46 N., R.43 W.

I, Richard L. Drahn, in a field survey on April 8, 19 99, do hereby certify that under requirements of P.A. 74, Michigan P.A. of 1970, the corner points mentioned in lines 1 and 2 above were in conformance with regulations and rules therefore as required in the current manual of survey instructions of the United States Department of the Interior, Bureau of Land Management or by a decree of a Court of Law and/or that the corner points mentioned in lines 3, 4 and 5 above were in conformance with the rules of the Michigan Board of Land Surveyors or by a Decree of a Court of Law; established, re-established, monumented, re-monumented, recovered, found as expressed below:

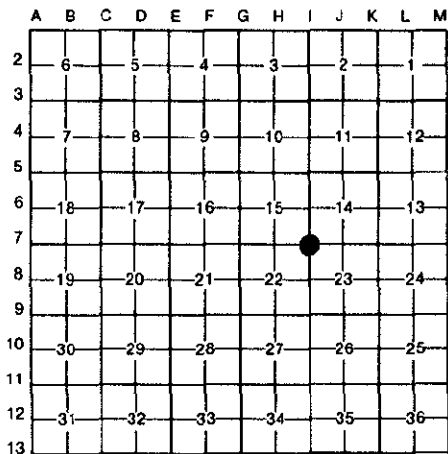

NOTE: Not more than 4 corners, all in the same town and range, may be recorded on this certificate.

A. Description of original monument and accessories and/or subsequent restoration:

Corner established by Austin Burt on 7/17/1851. Original B.T.s ---Y. Birch 12" S. 74 W. 18 links (11.88') --- Sugar 14" N.06 E. 24 links (15.84') ---
 Corner restored by Richard L. Drahn, RLS 21564 by retracement measurement to line trees west, south and north; natural feature ties east, and to recovered corners east and south. (October 22, 1984)

He set a 2" X 30" aluminum pipe with a 3 1/4" stamped aluminum cap and the following new bearing trees:

- 16" Sugar Maple N.78 W. 20.43'
- 7" Sugar Maple N.12 E. 15.56'

B. Description of corner evidence found and/or method applied in restoring or reestablishing corner:

- 10" Sugar Maple S.81 E. 32.80'
- 6' Steel sign rail N.50 E. 1.77'

Corner recorded in Gogebic County Liber 2, Page 647 on 12/10/84.

Corner research on file with Gogebic County records.

Recovered the monument as described and the bearing trees as follows:

- 17" Sugar Maple N.76 W. 20.62' (new nail)
- 9" Sugar Maple N.12 E. 15.56'
- 13" Sugar Maple S.81 E. 32.80' (new nail)
- 6' Steel sign rail N.50 E. 1.83'

No evidence remains of the original corner or bearing trees.

C. Description of monument for corner and accessories established to perpetuate locating the position of the corner:

New bearing tree referenced:

- 10" Sugar Maple S.08 E. 42.26'

Richard L. Drahn 5/11/99
 COURT REGISTRAR



Signed by Richard L. Drahn Date April 11, 1999

Surveyor's Michigan License No. 21564