

MAR 02 2000

SECTION

LAND CORNER RECORDATION CERTIFICATE  
Filing Requirement of Act 74, Mich. P.A. 1970

Register's Office }  
Gogebic County } ss.

Received for record the  
10<sup>th</sup> day of JUNE  
A. D. 1999 at 10:05 o'clock  
A M., and recorded in  
Liber 7 of CORNERS  
on page 159.  
Ramona Collins, Deputy  
Register of Deeds

For corners in

<u>Gogebic</u> (County)	Located In:	Corner Code #
1. Public Land Survey	T <u>46N</u> R <u>43W</u>	<u>J-11</u>
	T _____ R _____	_____
	T _____ R _____	_____
	T _____ R _____	_____
2. Property Controlling in Section	S _____ T _____ R _____	_____
	S _____ T _____ R _____	_____
3. Miscellaneous Property in Sec.	S _____ T _____ R _____	_____
	S _____ T _____ R _____	_____

Register of Deeds Stamp & File Number

4. Lot No. \_\_\_\_\_, Recorded Plat \_\_\_\_\_  
5. Private Claims \_\_\_\_\_

Quarter Corner 26 & 35; T.46 N., R.43 W.

I, Richard L. Drahn, in a field survey on June 8, 1999 do hereby state that under requirements of P.A. 74, Michigan P.A. of 1970, the corner points mentioned in lines 1 and 2 above were in conformance with regulations and rules therefore as required in the current manual of survey instructions of the United States Department of the Interior, Bureau of Land Management or by a decree of a Court of Law and /or that the corner points mentioned in lines 3, 4 and 5 above were in conformance with the rules of the Michigan Board of Land Surveyors or by a Decree of a Court of Law; established, re-established, monumented, recovered, found as expressed below:

	A	B	C	D	E	F	G	H	I	J	K	L	M
1													
2		6		5		4		3		2		1	
3													
4		7		8		9		10		11		12	
5													
6		10		17		16		15		14		13	
7													
8		19		20		21		27		23		24	
9													
10		30		29		28		27		26		25	
11										●			
12		31		32		33		34		35		36	
13													

NOTE: Not more than 2 corners, all in the same town and range, may be recorded on this certificate.

A. Description of original monument and accessories and/or subsequent restoration:

Original corner established by Austin Burt on 9/4/1851. Original corner: Cedar 12"

Hemlock 24" S.45° E. 14 links (9.24')

B. Description of corner evidence found and/or method applied in restoring or reestablishing corner:

Restored corner position in the center of a series of root holes located in a small depression (species undetermined); at record bearing and distance from the remains of the original bearing tree. It is now a very large, badly decayed Hemlock windfall. Portions of the major roots, Hemlock bark and a downwind line of branch knots are all that remain. The 5.94 chain distance west to "Enter swamp, N-S" is in accordance with the field notes of the original Government survey.


Corner research on file with Gogebic County records.

C. Description of monument for corner and accessories established to perpetuate locating the position of the corner:

At the corner position I set a 2" x 30" aluminum pipe monument with a 3 1/4" stamped aluminum cap and the following new B.T.s (all measurements taken to a nail in side of tree).

Sugar Maple	10"	East	20.45'
Sugar Maple	12"	N.59°W.	12.73'
Sugar Maple	6"	S.20° W.	28.54'
Steel sign rail	6"	N.32° E.	2.33'

DEED GROUP APPROVED  
Richard L. Drahn 6/9/99  
COUNTY REGISTER

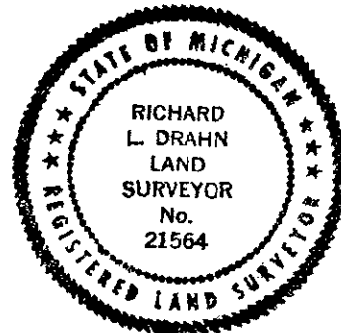

Signed by Richard L. Drahn Date June 9, 1999

Surveyor's Michigan License No. 21564

FORM APPROVED BY MICHIGAN STATE BOARD OF PROFESSIONAL SURVEYORS, JAN. 28, 1971  
REVISED MAY 14, 1975