

MAR 02 2000

SECTION

LAND CORNER RECORDATION CERTIFICATE  
Filing Requirement of Act 74, Mich. P.A. 1970

Register's Office }  
Gogebic County } ss.

For corners in

<u>Gogebic</u> (County)	Located In:	Corner Code #
1. Public Land Survey	T <u>46N</u> R <u>43W</u>	<u>K-6</u>
	T _____ R _____	_____
	T _____ R _____	_____
	T _____ R _____	_____
2. Property Controlling in Section	S _____ T _____ R _____	_____
	S _____ T _____ R _____	_____
3. Miscellaneous Property in Sec.	S _____ T _____ R _____	_____
	S _____ T _____ R _____	_____

Received for record the  
10<sup>TH</sup> day of JUNE  
A. D. 1999 at 10:05 o'clock  
A. m., and recorded in  
Liber 7 of CORNERS  
on page 162  
Ramona Collins, Deputy  
Register of Deeds

Register of Deeds Stamp & File Number

1/4 Corner, Sections 13 & 14; T.46 N., R.43 W.

4. Lot No. \_\_\_\_\_, Recorded Plat \_\_\_\_\_

5. Private Claims \_\_\_\_\_

I, Richard L. Drahn, in a field survey on May 14, 1999 do hereby state that under requirements of P.A. 74, Michigan P.A. of 1970, the corner points mentioned in lines 1 and 2 above were in conformance with regulations and rules therefore as required in the current manual of survey instructions of the United States Department of the Interior, Bureau of Land Management or by a decree of a Court of Law and /or that the corner points mentioned in lines 3, 4 and 5 above were in conformance with the rules of the Michigan Board of Land Surveyors or by a Decree of a Court of Law; established, re-established, monumented, recovered, found as expressed below:

	A	B	C	D	E	F	G	H	I	J	K	L	M
1													
2		6		5		4		3		2		1	
3													
4		7		8		9		10		11		12	
5													
6		18		17		16		15		14		13	
7													
8		19		20		21		22		23		24	
9													
10		30		29		28		27		26		25	
11													
12		31		32		33		34		35		36	
13													

NOTE: Not more than 2 corners, all in the same town and range, may be recorded on this certificate.

A. Description of original monument and accessories and/or subsequent restoration:  
Original corner established by Austin Burt, U.S. Deputy Surveyor on 9/3/1851.

Original bearing trees:  
Spruce 6" S.25°W. 18 links (11.88')  
Cedar 8" N.48° E. 4 links ( 2.64')

1933 MSHD road plans for US Hiway #2 tied to this corner 45 feet north of station 1078+01.1.

Corner restored by Richard L. Drahn, RLS 21564 on 6/5/86 at the location of a downed Cedar post at record bearing and distance from the remains of the original Cedar B.T. and 45 feet south of the U.S. #2 centerline. He set a 3/4" X 4' aluminum rod monument with a


stamped, 31/4" aluminum cap and the following new B.T.s:  
"P.K. Nail" in U.S. #2 centerline, south 45.18'  
MSHD R.O.W. marker bears north 64.81'  
NW corner of a 30" culvert abutment bears S.62° E., 316.44'  
Steel sign rail 6' S.71° E. 2.1'

Corner recorded in Gogebic County Liber 4, Page 22 on 3/4/87.

B. Description of corner evidence found and/or method applied in restoring or reestablishing corner:

Recovered the monument as described and the bearing trees as follows:  
"P.K. Nail" missing  
MSHD R.O.W. marker bearing north 64.83'  
Steel sign rail 6' S.72° E. 2.00'  
Portions of the original Cedar bearing tree are still present

Corner research on file with Gogebic County records.

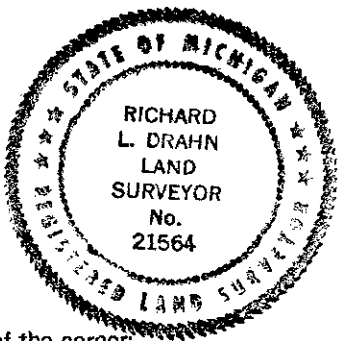

C. Description of monument for corner and accessories established to perpetuate locating the position of the corner:

New bearing object referenced:  
6' Carsonite sign rail S.21° W. 0.89'

FILE GROUP APPROVED  
Richard L. Drahn 6/9/99  
COUNTY CLERK

Signed by Richard L. Drahn Date May 17, 1999

Surveyor's Michigan License No. 21564

FORM APPROVED BY MICHIGAN STATE BOARD OF PROFESSIONAL SURVEYORS, JAN. 28, 1971  
REVISED MAY 14, 1976  
REVISED JAN., 1983