

MAR 02 2000

SECTION

LAND CORNER RECORDATION CERTIFICATE
Filing Requirement of Act 74, Mich. P.A. 1970

Register's Office }
Gogebic County } ss.

For corners in

<u>Gogebic</u> (County)	Located In:	Corner Code #
1. Public Land Survey	T46NR 43W	K-7
	T R	
	T R	
	T R	
2. Property Controlling in Section	S T R	
	S T R	
3. Miscellaneous Property in Sec.	S T R	
	S T R	

Received for record the
12th day of MAY
A. D. 1999 at 10:45 o'clock
A m., and recorded in
Liber 7 of CORNERS
on page 126
Ramona Collins, Deputy
Register of Deeds

Register of Deeds Stamp & File Number

4. Lot No. _____, Recorded Plat _____
5. Private Claims _____

Section Corner 13,14,23 & 24; T.46 N., R.43 W.

I, Richard L. Drahn in a field survey on May 19, 1999 do hereby state that under requirements of P.A. 74, Michigan P.A. of 1970, the corner points mentioned in lines 1 and 2 above were in conformance with regulations and rules therefore as required in the current manual of survey instructions of the United States Department of the Interior, Bureau of Land Management or by a decree of a Court of Law and/or that the corner points mentioned in lines 3, 4 and 5 above were in conformance with the rules of the Michigan Board of Land Surveyors or by a Decree of a Court of Law; established, re-established, monumented, recovered, found as expressed below:

NOTE: Not more than 2 corners, all in the same town and range, may be recorded on this certificate.

A	B	C	D	E	F	G	H	I	J	K	L	M
1												
2	6		5		4		3		2		1	
3												
4	7		8		9		10		11		12	
5												
6	18		17		16		15		14		13	
7												
8	19		20		21		22		23		24	
9												
10	30		29		28		27		26		25	
11												
12	31		32		33		34		35		36	
13												

A. Description of original monument and accessories and/or subsequent restoration:

Corner established by Austin Burt on 8/17/1851. Original B.T.s --- Fir 12" S.50 E. 36 links (23.76') --- Cedar 8" N.37 W. 26 links (17.16') --- Corner restored by Richard L. Drahn, RLS 21564 on 7/23/75 from the blazed remains of the original Cedar B.T.. He set a 2 1/2" X 5' iron pipe with a stamped 3" brass cap and the following B.T.s: --- Sugar Maple 5" N.08 E. 23.2' --- 8" Sugar Maple S.70 E. 7.8' --- 6" Sugar Maple S.07 E. 12.6' --- 7" Metal sign rail N.87 W. 2.0' ---

Corner recorded in Gogebic County Liber 1, Page 146 on 1/27/76.

B. Description of corner evidence found and/or method applied in restoring or reestablishing corner:

Recovered the monument as described and the bearing trees as follows:

8"	Sugar Maple	N.07 E.	23.19'	(new nail)
10"	Sugar Maple	S.65 E.	7.86'	(new nail)
6"	Dead Sugar Maple	S.04 E.	12.67'	(new nail)
7'	Steel sign rail	N.87 W.	2.00'	

The original Cedar B.T. is now a downed 14" Cedar with GLO Blazes.

Corner research on file with Gogebic County records.


C. Description of monument for corner and accessories established to perpetuate locating the position of the corner:

New bearing tree referenced:

13" Sugar Maple N.18 E. 29.03'

PEER GROUP APPROVED

Richard L. Drahn 5/11/99
COURT RECORDED

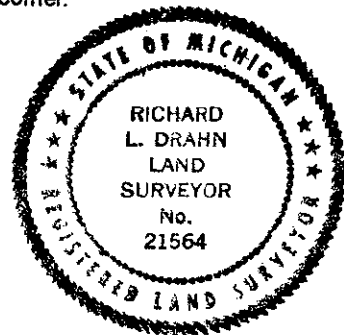

Signed by Richard L. Drahn
Surveyor's Michigan License No. 21564

Date May 11, 1999

USFS N-21