

MAR 02 2000

SECTION

LAND CORNER RECORDATION CERTIFICATE
Filing Requirement of Act 74, Mich. P.A. 1970

Register's Office }
Gogebic County } ss.

For corners in

Received for record the

Gogebic (County)

Located In:

Corner Code #

12 day of MAY
A. D. 1999 at 10:30 o'clock
A m., and recorded in
Liber 7 of CORNERS
on page 129

- 1. Public Land Survey T 46N R 43W Corner Code # K-11
T _____ R _____
T _____ R _____
T _____ R _____
- 2. Property Controlling S _____ T _____ R _____
in Section S _____ T _____ R _____
- 3. Miscellaneous S _____ T _____ R _____
Property in Sec. S _____ T _____ R _____


Ramona Collins, Deputy
Register of Deeds

Register of Deeds Stamp & File Number

- 4. Lot No. _____, Recorded Plat _____
- 5. Private Claims _____

Section Corner 25, 26, 35 & 36; T.46 N., R.43 W.

I, Richard L. Drahn in a field survey on 4/20/99, 19_____, do hereby certify that under requirements of P.A. 74, Michigan P.A. of 1970, the corner points mentioned in lines 1 and 2 above were in conformance with regulations and rules therefore as required in the current manual of survey instructions of the United States Department of the Interior, Bureau of Land Management or by a decree of a Court of Law and/or that the corner points mentioned in lines 3, 4 and 5 above were in conformance with the rules of the Michigan Board of Land Surveyors or by a Decree of a Court of Law; established, re-established, monumented, re-monumented, recovered, found as expressed below:

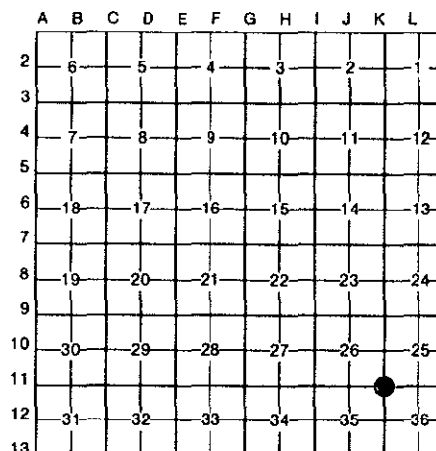

NOTE: Not more than 4 corners, all in the same town and range, may be recorded on this certificate.

A. Description of original monument and accessories and/or subsequent restoration:

Corner established by Austin Burt on 9/4/1851. Original B.T.s --- Hemlock 10" S.17 E. 36 links (23.76') --- Hemlock 14" N.23 W. 49 links (32.34') --- Corner restored by Richard L. Drahn, RLS 21564, on 7/15/75 from the remains of the two original B.T.s and from a line tree and natural feature ties. He set a 2½" X 60" iron pipe with a stamped 3" brass cap and the following new B.T.s: ---6" Sugar Maple N.42 W. 12.7' --- 8" Sugar Maple N.79E. 10.4' --- 5" Red Maple S.30 E. 16.8' --- 7' Metal sign post N.60 E. 2.0' --- Corner recorded in Gogebic County Liber 1, Page 152 on 1/27/76.

B. Description of corner evidence found and/or method applied in restoring or reestablishing corner:

Recovered the monument as described and the bearing trees as follows:
6" dead Sugar Maple N.32 W. 12.65'
9" Sugar Maple N.79 E. 10.47'
6" dead Red Maple S.31 E. 16.79'
7' Steel sign rail N.55 E. 1.98'

A badly decayed Hemlock stump remains from the first original B.T.. Hemlock wood and bark fragments in root holes remain from the second original B.T.. Corner research on file with Gogebic County records.

C. Description of monument for corner and accessories established to perpetuate locating the position of the corner:

New bearing trees referenced:

- 5" Red Maple S.03 W. 18.93'
- 9" Black Ash N.27 W. 39.22'

PEER GROUP APPROVED
Richard L. Drahn 5/11/99
COUNTY REGISTER



Signed by Richard L. Drahn

Date April 21, 1999

Surveyor's Michigan License No. 21564