

MAR 02 2000

SECTION

LAND CORNER RECORDATION CERTIFICATE
Filing Requirement of Act 74, Mich. P.A. 1970

For corners in

Gogebic
(County)

Located In:

Corner Code #

1. Public Land Survey

T 46N R 43W M-7

T R

T R

T 46N R 42W A-7

S T R

S T R

S T R

S T R

2. Property Controlling in Section

3. Miscellaneous Property in Sec.

4. Lot No. _____, Recorded Plat _____

5. Private Claims _____

Register's Office }
Gogebic County } ss.

Received for record the
12 day of MAY
A. D. 1999 at 10:30 o'clock
A m., and recorded in
Liber 7 of CORNERS
on page 132
Denora Collins DeWitt
Register of Deeds

Register of Deeds Stamp & File Number

Section Corner 13, 24, 18 & 19; T.46 N., R.42-43 W.
I, Richard L. Drahn in a field survey on May 5, 1999 do hereby state that under requirements of P.A. 74, Michigan P.A. of 1970, the corner points mentioned in lines 1 and 2 above were in conformance with regulations and rules therefore as required in the current manual of survey instructions of the United States Department of the Interior, Bureau of Land Management or by a decree of a Court of Law and /or that the corner points mentioned in lines 3, 4 and 5 above were in conformance with the rules of the Michigan Board of Land Surveyors or by a Decree of a Court of Law, established, re-established, monumented, recovered, found as expressed below:

	A	B	C	D	E	F	G	H	I	J	K	L	M
1													
2	6	5											
3													
4	7	8	9	10	11	12							
5													
6	10	17	16	15	14	13							
7													
8	19	20	21	22	23	24							
9													
10	30	29	28	27	26	25							
11													
12	31	32	33	34	35	36							
13													

NOTE: Not more than 2 corners, all in the same town and range, may be recorded on this certificate.

A. Description of original monument and accessories and/or subsequent restoration:

Corner established by John Burt on 8/6/1847. Original B.T.s --- Sugar 16" S.71 E. 12 links (7.92') --- Spruce 24" N.45 W. 26 links (17.16') --- Sugar 18" N.60 E. 52 links (34.32') ---
Corner position restored by Richard L. Drahn, RLS 21564 on 8/1/85 by re-tracement measurement to recovered line trees north, south, east & west. Logging road construction has destroyed the original corner and B.T.s. He set a 2" X 30" aluminum pipe with a 3 1/2" stamped aluminum cap and the following new B.T.s: --- 6" Sugar Maple N.24 W. 29.97' --- 6" Sugar Maple S.62 W. 55.59' --- 8" Sugar Maple S.28 E. 31.75' --- 6' Metal sign post S.53 E. 2.26'


B. Description of corner evidence found and/or method applied in restoring or reestablishing corner:

Corner recorded in Gogebic County Liber 2, Page 732 on 1/10/86.
Recovered the monument as described and the bearing trees as follows:
8" Sugar Maple N.22 W. 29.91'
7" Sugar Maple S.62 W. 55.62' (new nail)
10" Sugar Maple S.29 E. 31.74'
6' Steel sign rail S.55 E. 2.26'

C. Description of monument for corner and accessories established to perpetuate locating the position of the corner:

New bearing tree referenced:
8" Sugar Maple N.83 E. 57.44'

PEER GROUP APPROVED
Richard L. Drahn 5/11/99
COUNTY REGISTER

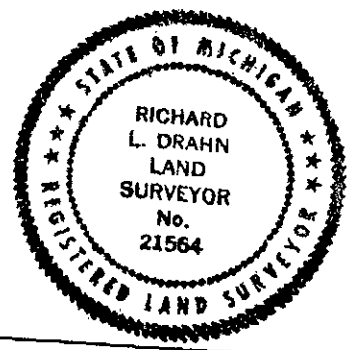

Signed by Richard L. Drahn
Surveyor's Michigan License No. 21564

Date May 6, 1999

USFS N-25