

MAR 02 2000

SECTION

LAND CORNER RECORDATION CERTIFICATE
Filing Requirement of Act 74, Mich. P.A. 1970

Register's Office }
Gogebic County } ss.

For corners in

Gogebic
(County)

Located In: Corner Code #

1. Public Land Survey

T 46N 43W M-12

T R

T R

T 46N 42W A-12

2. Property Controlling
in Section

S T R

S T R

3. Miscellaneous
Property in Sec.

S T R

S T R

Received for record the
12 day of MAY
A. D. 1999 at 10:30 o'clock
A m., and recorded in
Liber 7 of COARNERS
on page 139

Bernice Collins Deputi
Register of Deeds

Register of Deeds Stamp & File Number

4. Lot No. _____, Recorded Plat _____
5. Private Claims _____

Quarter Corner 31 & 36, T.46 N. R.43-42 W.

I, Richard L. Drahn in a field survey on April 2, 1999 do hereby state that under requirements of P.A. 74, Michigan P.A. of 1970, the corner points mentioned in lines 1 and 2 above were in conformance with regulations and rules therefore as required in the current manual of survey instructions of the United States Department of the Interior, Bureau of Land Management or by a decree of a Court of Law and/or that the corner points mentioned in lines 3, 4 and 5 above were in conformance with the rules of the Michigan Board of Land Surveyors or by a Decree of a Court of Law; established, re-established, monumented, recovered, found as expressed below:

NOTE: Not more than 2 corners, all in the same town and range, may be recorded on this certificate.

	A	B	C	D	E	F	G	H	I	J	K	L	M
1													
2	6		5		4		3		2		1		
3													
4	7		8		9		10		11		12		
5													
6	18		17		16		15		14		13		
7													
8	19		20		21		22		23		24		
9													
10	30		29		28		27		26		25		
11													
12	31		32		33		34		35		36		
13													

A. Description of original monument and accessories and/or subsequent restoration:

Corner established by John Burt on 8/6/1847. Original B.T.s --- Hemlock 18" S.82 E. 13 links (8.58') --- Cedar 12" N.25 W. 52 links (34.32') --- Corner position restored by Donald D. Lappala, RLS 12585 on 10/3/69 from the remains of the two original B.T.s and a line tree. He set a 2" X 5" iron pipe with a 3" stamped brass cap and the following: --- 4" Elm N.70 W. 16.4' --- 5" Yellow Birch N.10 W. 14.3' --- 7" Red Maple S.66 W. 26.3' --- Corner recorded in Gogebic County USFS Liber, Page X-1 on 4/8/70.

B. Description of corner evidence found and/or method applied in restoring or reestablishing corner:

Recovered the monument as described and the bearing trees as follows:
7" dead Elm N.09 W. 16.39' (new nail)
6" Yellow Birch down N.73 E. 14.20' (new nail)
10" Red Maple S.65 W. 26.28' (new nail)


The original B.T.s are now a badly decayed Hemlock stump and an extremely decayed Cedar windfall.

Corner research on file with Gogebic County records. Richard L. Drahn 5/11/99
COUNTY Gogebic

C. Description of monument for corner and accessories established to perpetuate locating the position of the corner:

New bearing trees established:

5" Red Maple N.36 W. 35.48'
5" Sugar Maple S.79 E. 49.87'
6' Steel sign rail S.40 E. 2.41'

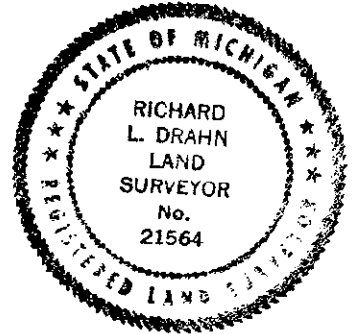

Signed by Richard L. Drahn
Surveyor's Michigan License No. 21564

Date May 2, 1999

USFS X-1