

MAR 02 2000

SECTION

LAND CORNER RECORDATION CERTIFICATE
Filing Requirement of Act 74, Mich. P.A. 1970

Register's Office }
Gogebic County } ss.

For corners in

Gogebic
(County)

Located In:

Corner Code #

1. Public Land Survey

T46NR 43W	M-13
T46NR 42W	A-13
T45NR 42W	A-1
T45NR 43W	M-1
S ___ T ___ R ___	___
S ___ T ___ R ___	___
S ___ T ___ R ___	___
S ___ T ___ R ___	___

2. Property Controlling in Section

3. Miscellaneous Property in Sec.

4. Lot No. _____, Recorded Plat _____
5. Private Claims _____

Received for record the
12 day of MAY
A. D. 1999 at 10:30 o'clock
A m., and recorded in
Liber 7 of CORNERS
page 140
Ramona Collins Deputy
Register of Deeds

Register of Deeds Stamp & File Number

Section Corner 36, 31, 1 & 6; T.45-46 N., R.42-42 W.
Richard L. Drahn, in a field survey on April 22 19 99 do hereby state that under requirements of P.A. 74, Michigan P.A. of 1970, the corner points mentioned in lines 1 and 2 above were in conformance with regulations and rules therefore as required in the current manual of survey instructions of the United States Department of the Interior, Bureau of Land Management or by a decree of a Court of Law and for that the corner points mentioned in lines 3, 4 and 5 above were in conformance with the rules of the Michigan Board of Land Surveyors or by a Decree of a Court of Law; established, re-established, monumented, recovered, found as expressed below:

1	A	B	C	D	E	F	G	H	I	J	K	L	M
2	6		5		4		3		2		1		
3													
4	7		8		9		10		11		12		
5													
6	18		17		16		15		14		13		
7													
8	19		20		21		22		23		24		
9													
10	30		29		28		27		26		25		
11													
12	31		32		33		34		35		36		

NOTE: Not more than 2 corners, all in the same town and range, may be recorded on this certificate.

A. Description of original monument and accessories and/or subsequent restoration:

Corner established by William A. Burt on 8/6/1847. Original B.T.s --- Y. Birch 18" N.31 E. 14 links (9.24') --- Sugar 16" S.70 W. 28 links (18.48') --- Corner position restored by Donald D. Lappala, RLS 12585 on 9/25/69 from the remains of the two original B.T.s. He set a 2" X 5' iron pipe with a 3" stamped brass cap and the following new B.T.s: --- 8" Yellow Birch N.75 W. 16.0' --- 14" Yellow Birch N.27 E. 47.5' --- 5" Sugar Maple S.34 W. 25.0' --- Corner recorded in Gogebic County USFS Liber, Page A-25 on 5/27/70.

B. Description of corner evidence found and/or method applied in restoring or reestablishing corner:

Recovered the monument as described and the bearing trees as follows:
8" Yellow Birch N.78 W. dead and down
19" Yellow Birch N.25 E. 47.42' (new nail)
8" Sugar Maple S.30 W. 24.96' (new nail)


The first original B.T. is now a very large, badly decayed Yellow Birch windfall. The Sugar is now a deep stump hole.

Corner research on file with Gogebic County records. Richard L. Drahn 5/11/99

C. Description of monument for corner and accessories established to perpetuate locating the position of the corner:

New bearing objects referenced:

5"	Sugar Maple	N.64 W.	28.98'
6'	Steel sign rail	S.71 E.	2.49'
4"X4"X7'	Cedar sign post	S.50 W.	2.48'

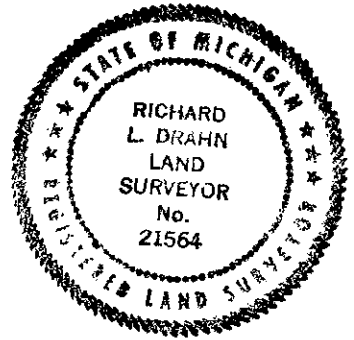

Signed by Richard L. Drahn

Surveyor's Michigan License No. 21564

Date May 2, 1999

USFS Z-25