SURVEY &
REMONUMENTATION

JAN 2 0 1999

SECTION

LAND CORNER MONUMENTS

T. 46 N., R. 43 W.

MARENISCO TOWNSHIP

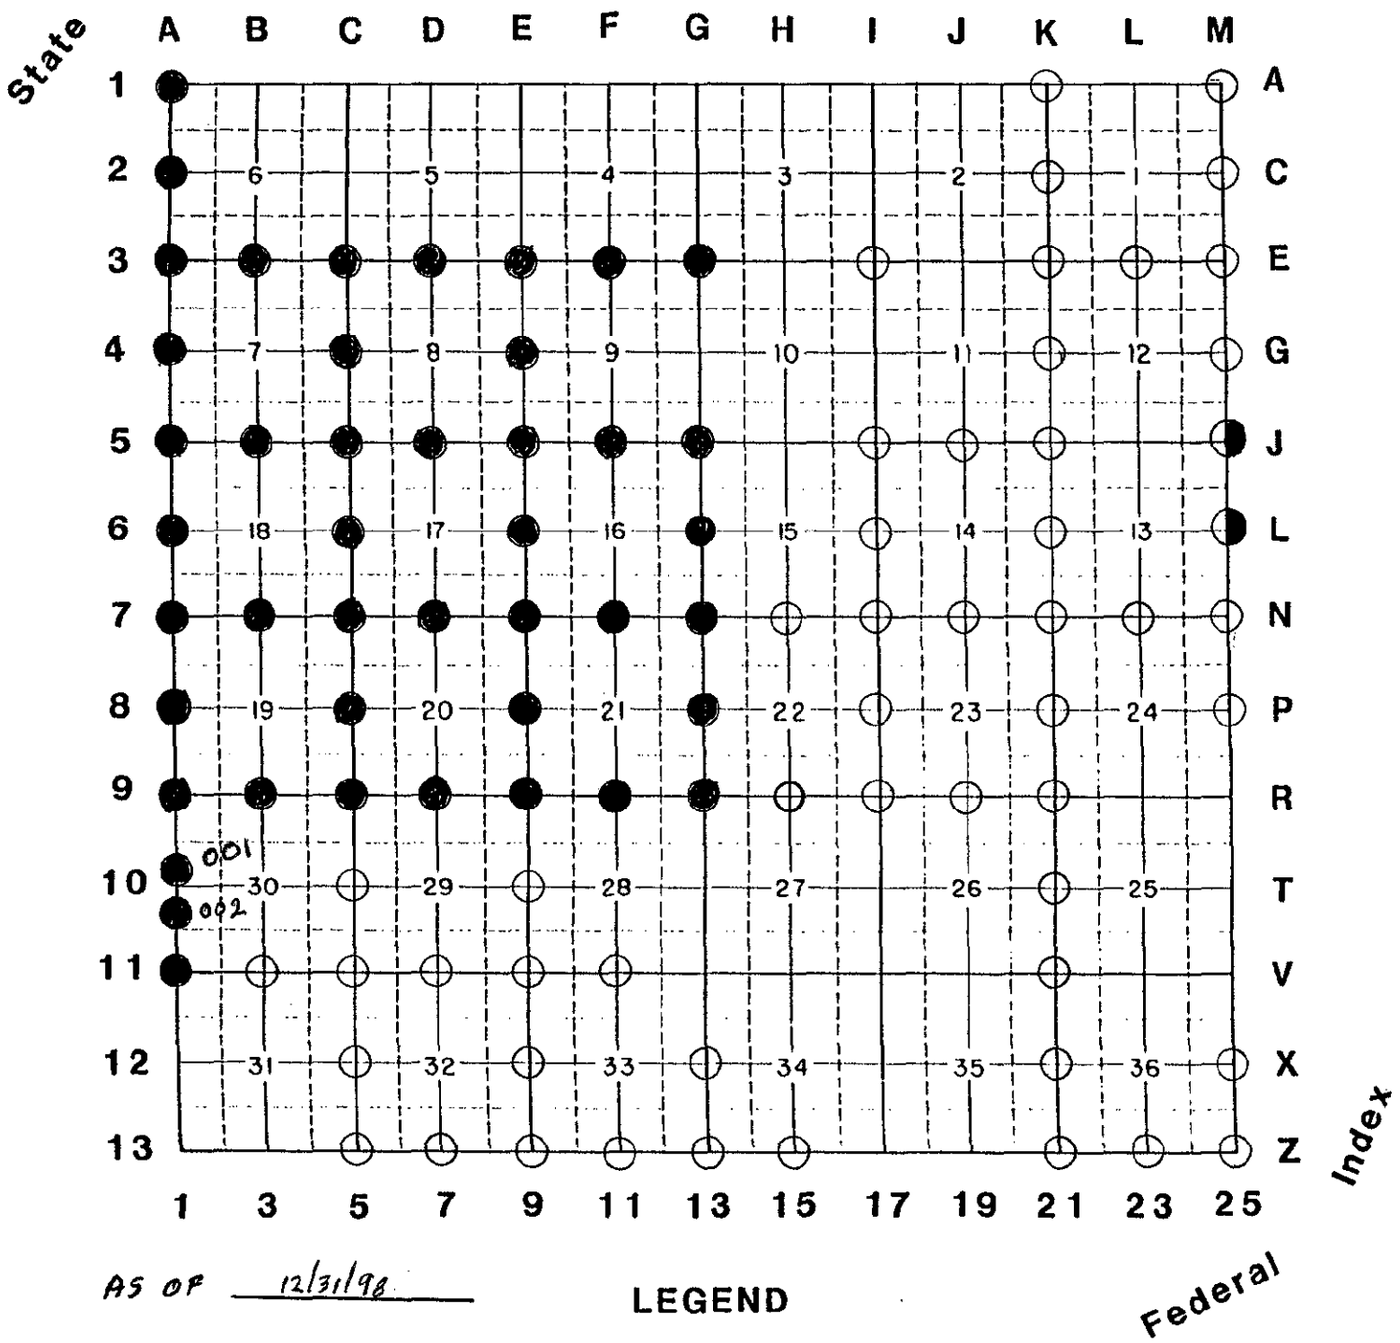

AS OF 12/31/98

LEGEND

○ GLO Corners researched

⊙ GLO Corners monumented, not approved

⊗ GLO Corners approved

● GLO Corners approved & reported to State

T. 46 N., R. 43 W.