

SURVEY & REMONUMENTATION

NOV 12 1997

COMMISSION

LAND CORNER RECORDATION CERTIFICATE
Filing Requirement of Act 74, Mich. P.A. 1970

Register's Office }
Gogebic County } ss.

For corners in

Gogebic
(County)

Located In:

Corner Code #

1. Public Land Survey

T 46N 44W B - 1
T 47N 44W B - 13

2. Property Controlling in Section

S T R

3. Miscellaneous Property in Sec.

S T R
S T R

Received for record the
18TH day of SEPTEMBER
A. D. 1997 at 10:45 o'clock
A m., and recorded in
Liber 6 of CORNER
page 195
Ramona Collins Deputy
Register of Deeds

Register of Deeds Stamp & File Number

4. Lot No. _____, Recorded Plat _____
5. Private Claims _____

I, John P. Goss, in a field survey on Sept. 3, 1997 do hereby state that under requirements of P.A. 74, Michigan P.A. of 1970, the corner points mentioned in lines 1 and 2 above were in conformance with regulations and rules therefore as required in the current manual of survey instructions of the United States Department of the Interior, Bureau of Land Management or by a decree of a Court of Law and /or that the corner points mentioned in lines 3, 4 and 5 above were in conformance with the rules of the Michigan Board of Land Surveyors or by a Decree of a Court of Law; established, re-established, monumented, recovered, found as expressed below:

NOTE: Not more than 2 corners, all in the same town and range, may be recorded on this certificate.

1/4 cor. comm. to sec's 6 & 31

A	B	C	D	E	F	G	H	I	J	K	L	M
1	●											
2	6	5	4	3					2	1		
3												
4	7	8	9	10	11	12						
5												
6	18	17	16	15	14	13						
7												
8	19	20	21	22	23	24						
9												
10	30	29	28	27	26	25						
11												
12	31	32	33	34	35	36						
13	●											

A. Description of original monument and accessories and/or subsequent restoration:

Original corner established by Austin Burt, in 1847.
Original bearing trees: Cedar 10" N 79° E 37 links
Cedar 14" N 25° W 40 links

On October 14, 1970, Donald D. Lappala, RLS, restored corner position at record bearing and distance from the remains of the two original bearing trees. Both stump holes. Corner position verified further by measurement west from corner to a record line tree. He set a 2½" iron pipe with 3" bronze cap which indicated the corner position. He established the following bearing trees: 7" W. Spruce N 01° E- 17.0'; 4" Cedar - S 55° E - 20.7'; 12" Cedar - S 18° E - 32.4'.

B. Description of corner evidence found and/or method applied in restoring or reestablishing corner:
Corner recorded in USFS Liber Z-3, on August 10, 1972.

Found Donald D. Lappala, monument and witnesses.

I updated the corner monument and accessories as noted below to state and county specification.

Act 74 research on file.

PEER GROUP APPROVED


Richard P. Deahn 9/17/97
COUNTY REPRESENTATIVE

C. Description of monument for corner and accessories established to perpetuate locating the position of the corner:

From the 2½" iron pipe with 3" bronze cap which read: T. 46-47 N., R.44 W.; 1/4; S-6, S-31; R.L.S. 12585; 1970, from which I established existing bearing trees and new reference objects.

12" White Spruce N 01° E 17.02'
7" Cedar S 55° E 20.24'
18" Cedar S 18° E 32.38'
4"x4" wood post & sign Due S. 1.95' (to face)
6" Rail & sign N 31° W 2.11' (to face)

All measurement to nail in side of tree)

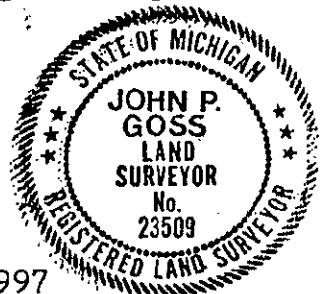

Signed by John P. Goss

Date September 3, 1997

Surveyor's Michigan License No. 23509

Fed. No. Z-3