

**LAND CORNER RECORDATION CERTIFICATE**  
**Filing Requirement of Act 74, Mich. P.A. 1970**

Register's Office }  
 Gogebic County } ss.

For corners in

Gogebic Located In: Corner Code #  
 (County)

1. Public Land Survey T46 N R44 W. C-2  
 T R  
 T R  
 T R

2. Property Controlling S T R SURVEY &  
 in Section S T R REMONUMENTATION

3. Miscellaneous S T R  
 Property in Sec. S T R JAN 05 2001

Received for record the  
26<sup>th</sup> day of MAY  
 A. D. 1900 at 10:35 o'clock  
A m., and recorded in  
 Liber 7 of CORNCUS


on page 282  
*Cheryl Ruppe*  
 Register of Deeds

Register of Deeds Stamp & File Number

4. Lot No. \_\_\_\_\_, Recorded Plat \_\_\_\_\_ SECTION  
 5. Private Claims \_\_\_\_\_

1/4 Corner 5 & 6; T.46 N., R.44 W.

I, Richard L. Drahn, in a field survey on May 15, 2000 do hereby state that under requirements of P.A. 74, Michigan P.A. of 1970, the corner points mentioned in lines 1 and 2 above were in conformance with regulations and rules therefore as required in the current manual of survey instructions of the United States Department of the Interior, Bureau of Land Management or by a decree of a Court of Law and /or that the corner points mentioned in lines 3, 4 and 5 above were in conformance with the rules of the Michigan Board of Land Surveyors or by a Decree of a Court of Law; established, re-established, monumented, recovered, found as expressed below:

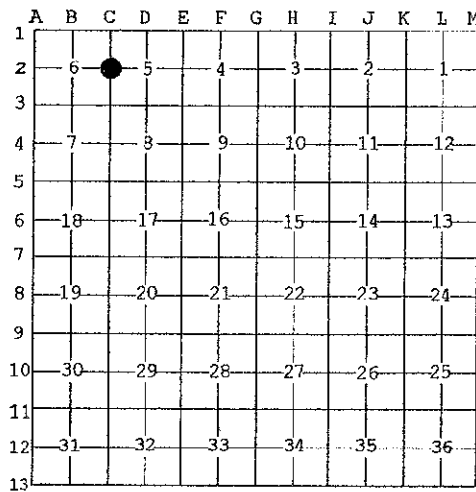

**NOTE: Not more than 2 corners, all in the same town and range, may be recorded on this certificate.**

A. Description of original monument and accessories and/or subsequent restoration:

Original corner established by Austin Burt on 8/13/1851. Original bearing trees:

|          |     |          |          |          |
|----------|-----|----------|----------|----------|
| Y. Birch | 12' | S.66° E. | 37 links | (24.42') |
| Fir      | 10' | N.46° W. | 38 links | (25.08') |

B. Description of corner evidence found and/or method applied in restoring or reestablishing corner:

Corner research on file with Gogebic County records.

Restored corner position at record bearing and distance from the stump hole of the original Yellow Birch bearing tree. No evidence remains of the original Fir bearing tree. The 2.25 chain distance south from corner to "Stream 6 links, NE" the 3.55 chain distance south from corner to "Enter swamp, NE" and the 7.45 chain distance north from corner to "leave swamp, E-W" are all in accordance with the field notes of the original Government survey.


C. Description of monument for corner and accessories established to perpetuate locating the position of the corner:

At the corner position I set a 3/4" X 4' aluminum rod monument with a 3 1/4" stamped aluminum cap and the following new bearing objects. (No trees available, corner in beaver meadow).

|                 |    |          |       |
|-----------------|----|----------|-------|
| Steel sign rail | 6' | N.01° W. | 4.57' |
| Steel sign rail | 6' | S.88° E. | 4.04' |
| Steel sign rail | 6' | South    | 3.66' |
| Steel sign rail | 6' | N.82° W. | 4.12' |

PEER GROUP APPROVED

*Richard L. Drahn* 05/24/00  
 COUNTY REGISTER

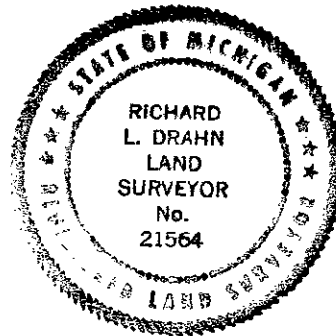

Signed by Richard L. Drahn Date May 17, 2000  
 Surveyor's Michigan License No. 21564