

LAND CORNER RECORDATION CERTIFICATE
Filing Requirement of Act 74, Mich. P.A. 1970

Register's Office }
 Gogebic County } ss.

Received for record the
26TH day of MAY
 A. D. 2000 at 10:35 o'clock
10 m., and recorded in
 Liber 7 of CORNERS
 page 203
Cheryl Ruspe
 Register of Deeds

Register of Deeds Stamp & File Number

For corners in

Gogebic Located In: Corner Code #
 (County)

1. Public Land Survey T46 N R44 W. C-3
 T R
 T R **SURVEY &**
 T R **MONUMENTATION**

2. Property Controlling in Section S T R
 S T R **JAN 05 2001**


3. Miscellaneous Property in Sec. S T R
 S T R **SECTION**

4. Lot No. _____, Recorded Plat _____
 5. Private Claims _____

Section Corner 5, 6, 7 & 8; T.46 N., R.44 W.

I, Richard L. Drahn, in a field survey on May 6, 2000 do hereby state that under requirements of P.A. 74, Michigan P.A. of 1970, the corner points mentioned in lines 1 and 2 above were in conformance with regulations and rules therefore as required in the current manual of survey instructions of the United States Department of the Interior, Bureau of Land Management or by a decree of a Court of Law and /or that the corner points mentioned in lines 3, 4 and 5 above were in conformance with the rules of the Michigan Board of Land Surveyors or by a Decree of a Court of Law; established, re-established, monumented, recovered, found as expressed below:

NOTE: Not more than 2 corners, all in the same town and range, may be recorded on this certificate.

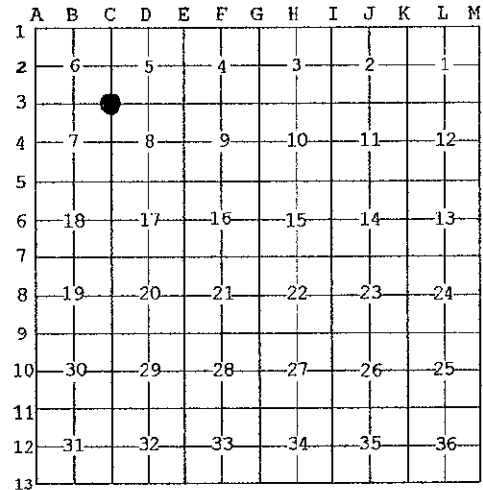

A. Description of original monument and accessories and/or subsequent restoration:

Original corner established by Austin Burt on 8/13/1851. Original bearing trees:

Maple	10"	S.52° E.	26 links	(17.16')
Maple	12"	N.54° W.	18 links	(11.88')

B. Description of corner evidence found and/or method applied in restoring or reestablishing corner:

Corner research on file with Gogebic County records.

Corner position restored at record bearing and distance from the remains of the two original bearing trees. The first is a series of root holes with identifiable fragments of Red Maple wood. The second one is now a windthrown stump hole. The 2.00 chain distance west to "stream 5 lks. NE," the 4.05 chains distance north to "stream 8 lks. NNE", (now an old stream channel) and the 2.30 chain distance east from corner to "leave swamp, NW" and all in accordance with the field notes of the original Government survey.

C. Description of monument for corner and accessories established to perpetuate locating the position of the corner:

At the corner location I set a 2" X 30" aluminum pipe with a 3 1/4" stamped aluminum cap and the following new bearing trees:

Sugar Maple	14"	N.49° W.	27.38'
Sugar Maple	11"	N.35° E.	25.14'
Hemlock	8"	S.10° E.	16.93'
Steel sign rail	6'	N.38° E.	2.59'

PEER GROUP APPROVED
Richard L. Drahn 05/24/00
 COUNTY REPRESENTATIVE



Signed by Richard L. Drahn Date May 12, 2000

Surveyor's Michigan License No. 21564