

SURVEY & REMONUMENTATION

NOV 12 1997

COMMISSION

LAND CORNER RECORDATION CERTIFICATE
Filing Requirement of Act 74, Mich. P.A. 1970

Register's Office }
Gogebic County } ss.

For corners in

Gogebic
(County)

Located In:

Corner Code #

1. Public Land Survey

Section 4	T 46N	R 44W	E 1
	T 47N	R 44W	E 13
	T	R	
	T	R	
2. Property Controlling in Section	S	T	R
	S	T	R
3. Miscellaneous Property in Sec.	S	T	R
	S	T	R

Received for record the
18th day of AUGUST
A. D. 1997 at 11:00 o'clock
A m., and recorded in
Liber 6 of CORNER
on page 179
Ramona Collins, Deputy
Register of Deeds

Register of Deeds Stamp & File Number

4. Lot No. _____, Recorded Plat _____
5. Private Claims _____

Section corner 4, 5, 32 & 33 T47-46N, R44W

I, John R. Garske, in a field survey on July 23, 19 do hereby state that under requirements of P.A. 74, Michigan P.A. of 1970, the corner points mentioned in lines 1 and 2 above were in conformance with regulations and rules therefore as required in the current manual of survey instructions of the United States Department of the Interior, Bureau of Land Management or by a decree of a Court of Law and/or that the corner points mentioned in lines 3, 4 and 5 above were in conformance with the rules of the Michigan Board of Land Surveyors or by a Decree of a Court of Law, established, re-established, monumented, recovered, found as expressed below:

A	B	C	D	E	F	G	H	I	J	K	L	M
1												
2	6		5		4		3		2		1	
3												
4	7		8		9		10		11		12	
5												
6	18		17		16		15		14		13	
7												
8	19		20		21		22		23		24	
9												
10	30		29		28		27		26		25	
11												
12	31		32		33		34		35		36	
13												

NOTE: Not more than 2 corners, all in the same town and range, may be recorded on this certificate.

A. Description of original monument and accessories and/or subsequent restoration:

Original Town Survey by Austin Burt D.S. in 1847. Original bearing trees:
10" y. birch N49E - 46l
9" cedar N22W - 14L

Corner reestablished by Donald Lappala RLS 12585 in 1970 and a Plat of Survey was recorded in 1982.
Recorded Liber 1, page 91.

B. Description of corner evidence found and/or method applied in restoring or reestablishing corner:


I found the Brass capped iron pipe as set by Lappala in 1970 in good condition as were his bearing trees. I up dated the corner as noted below.

PEER GROUP APPROVED
Richard L. Dealm 8/13/97
COUNTY REPRESENTATIVE

(Record Research on File)

C. Description of monument for corner and accessories established to perpetuate locating the position of the corner:

Found a 2 1/4" dia. brass capped pipe stamped from which:
12" hemlock S82°W 12.75 feet (existing)
9" hemlock N04°W 11.88 feet (existing)
10" y birch S48°E 24.03 feet (existing)
Wooden sign post NWLY 2.3' (existing)
Set a steel sign post - South 1.4 feet

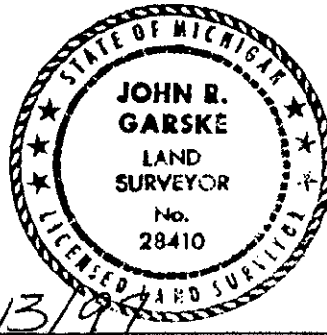

Signed by John R. Garske
Surveyor's Michigan License No. 28410

Date 8/13/97