

**LAND CORNER RECORDATION CERTIFICATE**  
**Filing Requirement of Act 74, Mich. P.A. 1970**

Register's Office }  
 Gogebic County } ss.

For corners in

Gogebic Located In: Corner Code #  
 (County)

1. Public Land Survey T46 N R44 W. E-5  
 T \_\_\_ R \_\_\_  
 T \_\_\_ R \_\_\_  
 T \_\_\_ R \_\_\_

2. Property Controlling in Section S \_\_\_ T \_\_\_ R \_\_\_  
 S \_\_\_ T \_\_\_ R \_\_\_

3. Miscellaneous Property in Sec. S \_\_\_ T \_\_\_ R \_\_\_  
 S \_\_\_ T \_\_\_ R \_\_\_

**SURVEY & MONUMENTATION**

JAN 05 2001

Received for record the  
26<sup>th</sup> day of MAY  
 A. D. 19 at 10:40 o'clock  
A m., and recorded in  
 Liber 7 of CORNERS  
 on page 293  
*Cheryl Rippe*  
 Dep. Register of Deeds


Register of Deeds Stamp & File Number

**SECTION**

4. Lot No. \_\_\_\_\_, Recorded Plat \_\_\_\_\_  
 5. Private Claims \_\_\_\_\_

Section Corner 8, 9, 16 & 17; T.46 N., R.44 W.

I, Richard L. Drahn, in a field survey on May 10, 2000 do hereby state that under requirements of P.A. 74, Michigan P.A. of 1970, the corner points mentioned in lines 1 and 2 above were in conformance with regulations and rules therefore as required in the current manual of survey instructions of the United States Department of the Interior, Bureau of Land Management or by a decree of a Court of Law and /or that the corner points mentioned in lines 3, 4 and 5 above were in conformance with the rules of the Michigan Board of Land Surveyors or by a Decree of a Court of Law; established, re-established, monumented, recovered, found as expressed below:

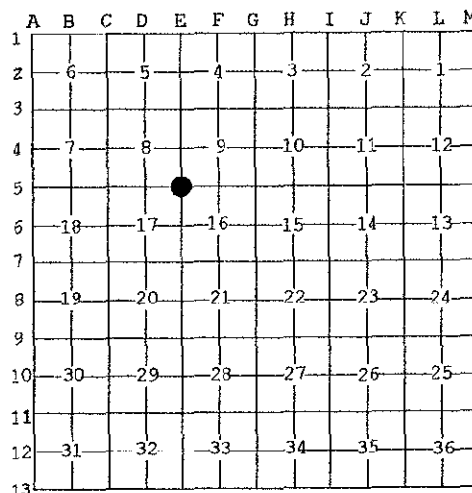

**NOTE: Not more than 2 corners, all in the same town and range, may be recorded on this certificate.**

A. Description of original monument and accessories and/or subsequent restoration:

Original corner established by Austin Burt on 8/14/1851. Original bearing trees:

Cedar	12"	S.63° E.	10 links	(6.60')
Fir	7"	N.65° W.	27 links	(17.82')

B. Description of corner evidence found and/or method applied in restoring or reestablishing corner:

Corner research on file with Gogebic County records.

Restored corner position at record bearing and distance from the remains of the two original bearing trees. The first one is a large series of root holes. (Examination of other dead in place upland Cedars in the area substantiate the root patterns, placement and relative size of decaying Cedars. The second one is now a large stump hole from a dead in place softwood.

C. Description of monument for corner and accessories established to perpetuate locating the position of the corner:

At the corner position I set a 2" x 30" aluminum pipe monument with a 3 1/4" stamped aluminum cap and the Following new B.T.s (all measurements taken to a nail in side of tree)

Sugar Maple	6"	N.13° W.	15.43'
Sugar Maple	8"	N.72° E.	18.11'
Sugar Maple	7"	S.51° W.	30.48'
Steel sign rail	6'	S.18° W.	1.89'

PEER GROUP APPROVED  
*Richard L. Drahn* 05/24/00  
 COUNTY REGISTER



Signed by Richard L. Drahn Date May 12, 2000  
 Surveyor's Michigan License No. 21564

FORM APPROVED BY MICHIGAN STATE BOARD OF PROFESSIONAL SURVEYORS, JAN. 28, 1971  
 REVISED MAY 14, 1975  
 REVISED JAN., 1983  
 REVISED OCT., 1995