

**LAND CORNER RECORDATION CERTIFICATE**  
**Filing Requirement of Act 74, Mich. P.A. 1970**

Register's Office }  
 Gogebic County } SO.

Received for record the  
26<sup>TH</sup> day of MAY  
 A. D. 2000 at 10:40 o'clock  
A. M., and recorded in  
 Liber 7 of CORNERS  
 on page 298  
*Cheryl Ruppe*  
 Dep. Register of Deeds

For corners in

Gogebic Located In: \_\_\_\_\_ Corner Code # \_\_\_\_\_  
 (County)

1. Public Land Survey T46 N R44 W. F-3  
 T \_\_\_\_\_ R \_\_\_\_\_  
 T \_\_\_\_\_ R \_\_\_\_\_  
 T \_\_\_\_\_ R \_\_\_\_\_

2. Property Controlling \_\_\_\_\_  
 in Section S \_\_\_\_\_ T \_\_\_\_\_ R \_\_\_\_\_

3. Miscellaneous \_\_\_\_\_  
 Property in Sec. S \_\_\_\_\_ T \_\_\_\_\_ R \_\_\_\_\_

**SURVEY &  
 REMONUMENTATION**

JAN 05 2001


Register of Deeds Stamp & File Number

SECTION

4. Lot No. \_\_\_\_\_, Recorded Plat \_\_\_\_\_  
 5. Private Claims \_\_\_\_\_

1/4 Corner 4 & 9; T.46 N., R.44 W.

I, Richard L. Drahn, in a field survey on April 7, 2000 do hereby state that under requirements of P.A. 74, Michigan P.A. of 1970, the corner points mentioned in lines 1 and 2 above were in conformance with regulations and rules therefore as required in the current manual of survey instructions of the United States Department of the Interior, Bureau of Land Management or by a decree of a Court of Law and /or that the corner points mentioned in lines 3, 4 and 5 above were in conformance with the rules of the Michigan Board of Land Surveyors or by a Decree of a Court of Law; established, re-established, monumented, recovered, found as expressed below:

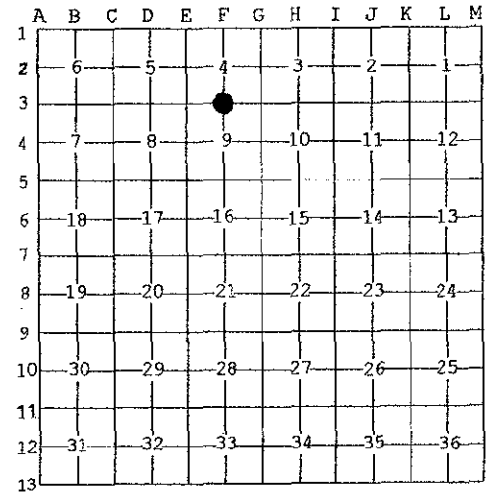

**NOTE:** Not more than 2 corners, all in the same town and range, may be recorded on this certificate.

A. Description of original monument and accessories and/or subsequent restoration:

Original corner established by Austin Burt on 8/22/1851. Original bearing trees:

Yellow Birch	14"	S.58° E.	17 links	(11.22')
Fir	12"	N.39° W.	04 links	(2.64')

Corner restored by Richard L. Drahn, RLS 21564 on 11/2/81 from the remains of the two original B.T.s, from a recovered line tree west and from natural features east and west. He set a 2" X 30" aluminum pipe with a 3 1/4" stamped aluminum cap and the following B.T.s:

Sugar Maple	5"	N.12° E.	16.45'
Sugar Maple	7"	S.60° E.	20.32'
Sugar Maple	4"	S.35° W.	27.89'
Steel sign rail	6'	N.12° W.	1.6'

Corner recorded in Gogebic County Liber 2, Page 222 on 3/10/82.

B. Description of corner evidence found and/or method applied in restoring or reestablishing corner:

Corner research on file with Gogebic County records.

Recovered the monument as described and the bearing trees as follows:

Sugar Maple	8"	N.11° E.	16.52'	(new nail)
Sugar Maple	9"	S.62° E.	20.34'	
Sugar Maple	6"	S.33° W.	27.91'	
Steel sign rail	6'	N.13° W.	1.59'	

Only stump holes remain from the original bearing trees.

C. Description of monument for corner and accessories established to perpetuate locating the position of the corner:

New bearing tree established:

Sugar Maple	9"	N.63° W.	16.18'
-------------	----	----------	--------

**PEER GROUP APPROVED**  
*Richard L. Drahn* 05/24/00  
 COUNTY REPRESENTATIVE



Signed by Richard L. Drahn Date May 2, 2000

Surveyor's Michigan License No. 21564

FORM APPROVED BY MICHIGAN STATE BOARD OF PROFESSIONAL SURVEYORS, JAN. 28, 1971  
 REVISED MAY 14, 1975  
 REVISED JAN., 1983  
 REVISED OCT., 1995