

LAND CORNER RECORDATION CERTIFICATE
Filing Requirement of Act 74, Mich. P.A. 1970

Register's Office }
 Gogebic County } ss.

Received for record the
26TH day of MAY
 A. D. 1900 at 10:40 o'clock
A m., and recorded in
 Liber 7 of CORNERS
 on page 299
Cheryl Russo
 Dep. Register of Deeds

For corners in

<u>Gogebic</u> (County)	Located In:	Corner Code #
1. Public Land Survey	<u>T46 N R44 W.</u>	<u>F-7</u>
	T ___ R ___	
	T ___ R ___	<u>SURVEY &</u>
	T ___ R ___	<u>REMONUMENTATION</u>
2. Property Controlling in Section	S ___ T ___ R ___	
	S ___ T ___ R ___	<u>JAN 05 2001</u>
3. Miscellaneous Property in Sec.	S ___ T ___ R ___	
	S ___ T ___ R ___	<u>SECTION</u>

Register of Deeds Stamp & File Number

4. Lot No. _____, Recorded Plat _____
 5. Private Claims _____

1/4 Corner 16 & 21; T.46 N., R.44 W.

I, Richard L. Drahn, in a field survey on April 26, 2000 do hereby state that under requirements of P.A. 74, Michigan P.A. of 1970, the corner points mentioned in lines 1 and 2 above were in conformance with regulations and rules therefore as required in the current manual of survey instructions of the United States Department of the Interior, Bureau of Land Management or by a decree of a Court of Law and /or that the corner points mentioned in lines 3, 4 and 5 above were in conformance with the rules of the Michigan Board of Land Surveyors or by a Decree of a Court of Law; established, re-established, monumented, recovered, found as expressed below:

A	B	C	D	E	F	G	H	I	J	K	L	M
1												
2	6	5	4	3	2	1						
3												
4	7	8	9	10	11	12						
5												
6	18	17	16	15	14	13						
7												
8	19	20	21	22	23	24						
9												
10	30	29	28	27	26	25						
11												
12	31	32	33	34	35	36						
13												

NOTE: Not more than 2 corners, all in the same town and range, may be recorded on this certificate.

A. Description of original monument and accessories and/or subsequent restoration:
 Original corner established by Austin Burt on 7/18/1851. Original bearing trees:
 Yellow Birch 14" S.47° E. 20 links* (13.20')
 Yellow Birch 10" N.57° W. 20 links (13.20')

*Field evidence substantiates a possible GLO field error of 5 links, (3.30').

Corner restored by Richard L. Drahn, RLS 21564 on 9/10/81 from the remains of the two original B.T.s and from recovered line trees east and west. The SE B.T. was recovered at S.47° E., 25 links (16.50'). He set a 2" X 30" aluminum pipe with a 3 1/4" stamped aluminum cap and the following new B.T.s:

Sugar Maple	10"	N.75° W.	31.03'
Sugar Maple	5"	N.73° E.	28.91'
Sugar Maple	9"	S.04° W.	14.01'
Steel sign rail	6'	S.03° E.	2.3'

Corner recorded in Gogebic County Liber 2, Page 224 on 3/10/82.

B. Description of corner evidence found and/or method applied in restoring or reestablishing corner:

Corner research on file with Gogebic County records.

Recovered the monument as described and the bearing trees as follows:


Sugar Maple	13'	N.75° W.	30.97'
Sugar Maple	8"	N.74° E.	28.89'
Sugar Maple	11"	S.04° W.	14.00' (new nail)
Steel sign rail	6'	S.01° W.	2.31'

A series of root holes and a stump hole are all that remain of the original bearing trees.

C. Description of monument for corner and accessories established to perpetuate locating the position of the corner:

New bearing tree referenced:
 Black Cherry 20" N.01° E. 19.59'

PEER GROUP APPROVED
Richard L. Drahn 05/24/00
 COUNTY REGISTERED

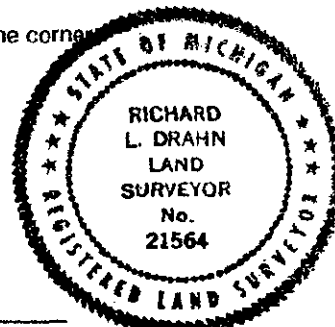

Signed by Richard L. Drahn Date April 30, 2000

Surveyor's Michigan License No. 21564