

LAND CORNER RECORDATION CERTIFICATE
Filing Requirement of Act 74, Mich. P.A. 1970

Register's Office }
Gogebic County } ss.

For corners in

Gogebic
(County)

Located in: Corner Code #

1. Public Land Survey

T 46 N R 44 W G-2
T R SURVEY &
T R MONUMENTATION
T R
S T R
S T R
S T R
S T R SECTION

2. Property Controlling in Section
3. Miscellaneous Property in Sec.

Received for record the
25TH day of MAY
A. D. 2000 at 10:40 o'clock
11 m., and recorded in
Liber 7 of CORNERS
page 300
Cepest Ruspe
Dep. Register of Deeds

Register of Deeds Stamp & File Number

4. Lot No. _____, Recorded Plat _____

5. Private Claims _____

Quarter Corner, Sections 3 & 4, T46N, R44W

I, John P. Goss, in a field survey on March 2, 2000 do hereby state that under requirements of P.A. 74, Michigan P.A. of 1970, the corner points mentioned in lines 1 and 2 above were in conformance with regulations and rules therefore as required in the current manual of survey instructions of the United States Department of the Interior, Bureau of Land Management or by a decree of a Court of Law and/or that the corner points mentioned in lines 3, 4 and 5 above were in conformance with the rules of the Michigan Board of Land Surveyors or by a Decree of a Court of Law; established, re-established, monumented, recovered, found as expressed below:

NOTE: Not more than 2 corners, all in the same town and range, may be recorded on this certificate.

	A	B	C	D	E	F	G	H	I	J	K	L	M
1													
2		6		5		4	●	3		2		1	
3													
4		7		8		9		10		11		12	
5													
6		18		17		16		15		14		13	
7													
8		19		20		21		22		23		24	
9													
10		30		29		28		27		26		25	
11													
12		31		32		33		34		35		36	
13													

A. Description of original monument and accessories and/or subsequent restoration:

Corner established by Austin Burt, on August 15, 1851.

Original bearing trees: Cedar 14" S 49° W 19 links (12.54 ft.)

Fir .6" N 84° E 17 links (11.22 ft.)

Richard L. Drahn, 21564, on October 19, 1981 re-established corner position at the corner position of very old fence lines east, south and west. He set a 2" I.D. aluminum pipe with a 3 1/2" aluminum cap, stamped to indicated the corner position. He established the following reference objects: 4" R. Maple S89°E - 22.63 ft.; 11" R. Maple - S18°E - 20.66 ft.; 4" Cedar - S52°W - 53.72 ft. 6' metal sign post - N 03° E - 1.9 ft.

B. Description of corner evidence found and/or method applied in restoring or reestablishing corner:

He recorded said corner in Liber 2, page 226 of Land Corners, on 3-10-82.

Found Richard L. Drahn, monument and accessories.

Act 74 research on file.

PEER GROUP APPROVED


Richard L. Drahn 05/24/00
COUNTY REGISTER

C. Description of monument for corner and accessories established to perpetuate locating the position of the corner:

From the found monument I established the following new and existing reference objects:

6" Red Maple (stub) S 89° E 22.63 ft.
18" Red Maple S 18° E 20.66 ft. (new nail)
7" Cedar S 52° W 53.72 ft.
9" Balsam S 70° E 58.80 ft.
6' metal sign post N 03° E 1.9 ft. (to face)

(All measurement taken to nail in side of tree)

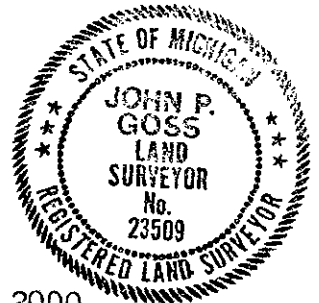

Signed by John P. Goss
Surveyor's Michigan License No. 23509

Date March 2, 2000

USFS # G-13