

**LAND CORNER RECORDATION CERTIFICATE**  
**Filing Requirement of Act 74, Mich. P.A. 1970**

Register's Office }  
 Gogebic County } ss.

Received for record the  
26<sup>TH</sup> day of MAY  
 A. D. 2000 at 10:50 o'clock  
A m., and recorded in  
 Liber 7 of CORNERS  
 \*\* page 305  
*Cheryl Respe*  
 Dep. Register of Deeds

For corners in

Gogebic Located In: Corner Code #  
 (County)

1. Public Land Survey T46 N R44 W. G-7  
 T \_\_\_ R \_\_\_ SURVEY &  
 T \_\_\_ R \_\_\_ MONUMENTATION  
 T \_\_\_ R \_\_\_

2. Property Controlling S \_\_\_ T \_\_\_ R \_\_\_  
 in Section S \_\_\_ T \_\_\_ R \_\_\_ JAN 05 2001

3. Miscellaneous S \_\_\_ T \_\_\_ R \_\_\_  
 Property in Sec. S \_\_\_ T \_\_\_ R \_\_\_ SECTION

Register of Deeds Stamp & File Number

4. Lot No. \_\_\_\_\_, Recorded Plat \_\_\_\_\_  
 5. Private Claims \_\_\_\_\_

Section Corner 15, 16, 21 & 22; T.46 N., R.44 W..

I, Richard L. Drahn, in a field survey on May 3, 2000 do hereby state that under requirements of P.A. 74, Michigan P.A. of 1970, the corner points mentioned in lines 1 and 2 above were in conformance with regulations and rules therefore as required in the current manual of survey instructions of the United States Department of the Interior, Bureau of Land Management or by a decree of a Court of Law and /or that the corner points mentioned in lines 3, 4 and 5 above were in conformance with the rules of the Michigan Board of Land Surveyors or by a Decree of a Court of Law; established, re-established, monumented, recovered, found as expressed below:

A	B	C	D	E	F	G	H	I	J	K	L	M
1												
2	6		5		4		3		2		1	
3												
4	7		8		9		10		11		12	
5												
6	18		17		16		15		14		13	
7												
8	19		20		21		22		23		24	
9												
10	30		29		28		27		26		25	
11												
12	31		32		33		34		35		36	
13												

NOTE: Not more than 2 corners, all in the same town and range, may be recorded on this certificate.

A. Description of original monument and accessories and/or subsequent restoration:  
 Original corner established by Austin Burt on 7/18/1851. Original bearing trees:  
 Spruce 12" S.27° E. 26 links (17.16')  
 Spruce 8" N.74° W. 16 links (10.56')

Corner restored by Richard L. Drahn, RLS 21564 on 6/2/82 at the site of the point of the original post recovered under 1 1/2 ft of swamp litter and at proportioned location from recovered line trees east, west and north. No evidence remained of the original B.T.s. He set a 2" X 5' iron pipe with a 3" stamped brass cap and the following new bearing trees:

Cedar 5" S.78° E. 108.80'  
 Balsam 8" S.21° E. 88.22'  
 Balsam 5" S.63° W. 51.58'  
 Steel sign rail 6' S.86° E. 2.75'

Corner recorded in Gogebic County; Liber 2, Page 384 on 3/15/83.

B. Description of corner evidence found and/or method applied in restoring or reestablishing corner:

Corner research on file with Gogebic County records.

Recovered the monument as described and the bearing trees as follows:

Cedar 8" S.79° W. 108.40' (New nail)  
 Balsam (dead) 8" S.22° E. 88.20'  
 Balsam (dead and down) 5" S.66° W.  
 Steel sign rail 6' S.86° E. 2.79'


No evidence remains of the original bearing trees.

C. Description of monument for corner and accessories established to perpetuate locating the position of the corner:

New bearing objects referenced:

Steel sign rail 6' N.38° W. 2.95'  
 Steel sign rail 6' S.19° W. 3.08'

DEED GROUP APPROVED  
*Richard L. Drahn* 05/24/00  
 COUNTY REGISTERING

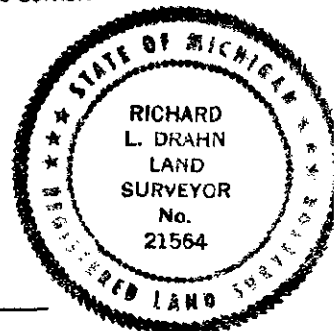

Signed by Richard L. Drahn Date May 12, 2000  
 Surveyor's Michigan License No. 21564  
 USFS N-13