

MAR 08 2000

SECTION

LAND CORNER RECORDATION CERTIFICATE
Filing Requirement of Act 74, Mich. P.A. 1970

For corners in

<u>Gogebic</u> (County)	Located In:	Corner Code #
1. Public Land Survey Section 14	T <u>46N</u> R <u>44W</u>	I-7 _____
	T _____ R _____	_____
	T _____ R _____	_____
	T _____ R _____	_____
2. Property Controlling in Section	S _____ T _____ R _____	_____
	S _____ T _____ R _____	_____
3. Miscellaneous Property in Sec.	S _____ T _____ R _____	_____
	S _____ T _____ R _____	_____

Register's Office }
Gogebic County }


Received for record the
26th day of AUGUST
A. D. 1999 at 1:35 o'clock
P m., and recorded in
Liber 7 of CORNERS
on page 222
Ramona Collins, Deputy
Register of Deeds

Register of Deeds Stamp & File Number

4. Lot No. _____, Recorded Plat _____
5. Private Claims Section corner common to sections 14, 15, 22, & 23

John R. Garske June 17, 99

I, _____, in a field survey on _____, 19____ do hereby state that under requirements of P.A. 74, Michigan P.A. of 1970, the corner points mentioned in lines 1 and 2 above were in conformance with regulations and rules therefore as required in the current manual of survey instructions of the United States Department of the Interior, Bureau of Land Management or by a decree of a Court of Law and for that the corner points mentioned in lines 3, 4 and 5 above were in conformance with the rules of the Michigan Board of Land Surveyors or by a Decree of a Court of Law; established, re-established, monumented, recovered, found as expressed below:

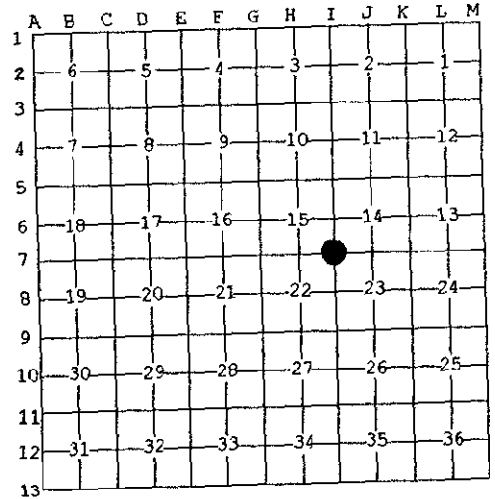

NOTE: Not more than 2 corners, all in the same town and range, may be recorded on this certificate.

A. Description of original monument and accessories and/or subsequent restoration:

Original survey by Austin Burt, D.S. in July 1851
Original Bearing Trees:

sugar maple 12"	S28°W	48 links
sugar maple 14"	N08°E	10 links

Corner restored by Donald Lappala, RLS #12585, from the remains of the two original bearing trees in 1972, He set a 2" concrete filled iron pipe with a 3" dia. bronze stamped cap from which:

12" elm	N60°E	22.2 feet
8" elm	S40°E	31.1 feet
8" Elm	S09°W	26.3 feet

**BTS
(DEAD)**

B. Description of corner evidence found and/or method applied in restoring or reestablishing corner:

I found the monument as described above. I set nails in the trees and recorded new ties as noted below.

(Research on file)

DEED GROUP APPROVED

Richard H. Drabin 8/24/99
COUNTY REGISTER

C. Description of monument for corner and accessories established to perpetuate locating the position of the corner:

Established the following witnesses: **ALL NEW**

6" twin sugar maple	N07°E	31.13 feet
metal sign post	N59°E	2.18 feet
8" sugar maple	S13°W	24.19 feet
8" sugar maple	S63°W	26.47 feet



Signed by John R. Garske
Surveyor's Michigan License No. 28410

Date 8/24/99