

**LAND CORNER RECORDATION CERTIFICATE**  
 Filing Requirement of Act 74, Mich. P.A. 1970

Register's Office }  
 Saghebic County } ss.

Received for record the  
26<sup>TH</sup> day of MAY  
 A. D. 2000 at 11:00 o'clock  
A m., and recorded in  
 Liber 7 of CORNERS  
 at page 315  
*Cheryl Ruppe*  
 Reg. Register of Deeds

Register of Deeds Stamp & File Number

For corners in  
GOGEBIC  
 (County)  
 Located In: Corner Code #  
 1. Public Land Survey T 46N R 44W I-9  
 T \_\_\_ R \_\_\_  
 T \_\_\_ R \_\_\_ SURVEY &  
 T \_\_\_ R \_\_\_ MONUMENTATION  
 2. Property Controlling S \_\_\_ T \_\_\_ R \_\_\_  
 in Section S \_\_\_ T \_\_\_ R \_\_\_ JAN 05 2001  
 3. Miscellaneous S \_\_\_ T \_\_\_ R \_\_\_  
 Property in Sec. S \_\_\_ T \_\_\_ R \_\_\_ SECTION

4. Lot No. \_\_\_\_\_, Recorded Plat \_\_\_\_\_  
 5. Private Claims \_\_\_\_\_

Section Corner, Sections 22, 23, 26 & 27, T46N, R44W

I, John P. Goss, in a field survey on April 12, 2000 do hereby state that under requirements of P.A. 74, Michigan P.A. of 1970, the corner points mentioned in lines 1 and 2 above were in conformance with regulations and rules therefore as required in the current manual of survey instructions of the United States Department of the Interior, Bureau of Land Management or by a decree of a Court of Law and/or that the corner points mentioned in lines 3, 4 and 5 above were in conformance with the rules of the Michigan Board of Land Surveyors or by a Decree of a Court of Law; established, re-established, monumented, recovered, found as expressed below:

	A	B	C	D	E	F	G	H	I	J	K	L	M
1													
2	6		5		4		3		2		1		
3													
4	7		8		9		10		11		12		
5													
6	18		17		16		15		14		13		
7													
8	19		20		21		22		23		24		
9													
10	30		29		28		27		26		25		
11													
12	31		32		33		34		35		36		
13													

NOTE: Not more than 2 corners, all in the same town and range, may be recorded on this certificate.

A. Description of original monument and accessories and/or subsequent restoration:  
 Corner established by Austin Burt, in 1851.

Original bearing trees: Sugar Maple 12" S 52° E 34 links (22.44 ft.)  
 Sugar Maple 12" N 75° W 26 links (17.16 ft.)  
 Donald D. Lappal, 12585, on October 16, 1967, restored corner position from the remains of the two original bearing trees. He set a 2" I.D. iron pipe with a 3" bronze cap, stamped to indicated corner position. He established the following bearing trees: S. Maple - N 65° W - 22 ft.; 7" S, Maple - N 25° E - 29.5 ft.; 8" S. Maple - S 21° W - 18.6 ft. (now out).  
 On June 6, 1968, he recorded said corner in U.S.F.S. Liber, Index No. R-17.

B. Description of corner evidence found and/or method applied in restoring or reestablishing corner:  
 Found no original evidence.

Found D. Lappala, monument and accessories.


Act 74 research on file.

*Richard L. Duda*  
 COURT DEEDS & RECORDS

C. Description of monument for corner and accessories established to perpetuate locating the position of the corner:  
 From the found monument, stamped to read: T.46 N., R.44 W.; S-22, S-23, S-26, S-27; R.L.S. 12585, 1967, from which I established the following existing and new reference objects:

- 12" Sugar Maple N 65° W 20.95 ft.
- 14" Sugar Maple N 25° E 29.40 ft.
- 14" Sugar Maple S 22° E 22.42 ft.
- 4" by 4" wood sign post N 77° W 2.8 ft. to face

(All measurement taken to nail in side of tree)

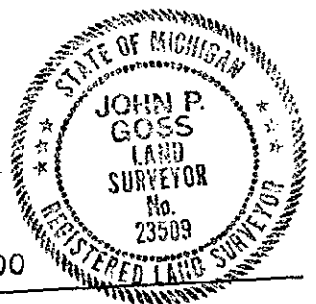

Signed by John P. Goss  
 Surveyor's Michigan License No. 23509  
 U.S.F.S. No. R-17

Date April 12, 2000