

**SURVEY & MONUMENTATION**

OCT 03 1996

COMMISSION

**LAND CORNER RECORDATION CERTIFICATE**  
**Filing Requirement of Act 74, Mich. P.A. 1970**

Register's Office }  
 Gogebic County } sa.

For corners in

<u>Gogebic</u> (County)	Located In:	Corner Code #
1. Public Land Survey	T 47N R 44W	J-13
	T 46N R 44W	J-1
2. Property Controlling in Section	S T R	
3. Miscellaneous Property in Sec.	S T R	

Received for record the  
10<sup>th</sup> day of JUNE  
 A. D. 1996 at 10:00 o'clock  
A m., and recorded in  
 Liber 5 of CORNERS  
 on page 387  
*Ramona Cullum Deputy*  
 Register of Deeds

Register of Deeds Stamp & File Number

- 4. Lot No. \_\_\_\_\_, Recorded Plat \_\_\_\_\_
- 5. Private Claims \_\_\_\_\_

$\frac{1}{4}$  Corner 35 & 2; T.46-47 N., R.44 W.

I, Richard L. Drahn, in a field survey on May 27, 19 96, do hereby certify that under requirements of P.A. 74, Michigan P.A. of 1970, the corner points mentioned in lines 1 and 2 above were in conformance with regulations and rules therefore as required in the current manual of survey instructions of the United States Department of the Interior, Bureau of Land Management or by a decree of a Court of Law and/or that the corner points mentioned in lines 3, 4 and 5 above were in conformance with the rules of the Michigan Board of Land Surveyors or by a Decree of a Court of Law; established, re-established, monumented, re-monumented, recovered, found as expressed below:

A	B	C	D	E	F	G	H	I	J	K	L	M
2	6	5	4	3	2							
3												
4	7	8	9	10	11	12						
5												
6	18	17	16	15	14	13						
7												
8	19	20	21	22	23	24						
9												
10	30	29	28	27	26	25						
11												
12	31	32	33	34	35	36						
13												

**NOTE: Not more than 4 corners, all in the same town and range, may be recorded on this certificate.**

A. Description of original monument and accessories and/or subsequent restoration:  
 Corner established by Austin Burt on August 27, 1847. Original B.T.s--- Sugar 8" N.35 E. 29 links (19.14') --- Y. Birch 10" N.40 W. 31 links (20.46') --- Corner restored by Donald D. Lappala, RLS 12585 on 6/8/71 from the remains of the original bearing trees. He set a 2" iron pipe with a 3" stamped brass cap and the following new bearing trees --- 10" (8") Sugar Maple N.05 E. (N.05 E.) 12.0' (12.05') --- 9" (9") Sugar Maple S.54 E. (S.51 E.) 11.2' (11.18') --- 7" (7") Y. Birch S.40 W. (S.39 W.) 8.9' (8.97') --- 4" X 4" Cedar sign post s.78 E. (S.79 E.) 2.6' (2.6')

Corner recorded in Gogebic County in USFS Liber, Page Z-19 on 8/10/72.

B. Description of corner evidence found and/or method applied in restoring or reestablishing corner:  
 Act 74 research form on file with Gogebic County records.


Recovered the monument as described and the bearing objects as noted in parentheses above.

A depression remains from the original Sugar bearing tree.

**PEER GROUP APPROVED**  
*Richard L. Drahn 6/6/96*  
 COUNTY REPRESENTATIVE

C. Description of monument for corner and accessories established to perpetuate locating the position of the corner:  
 Bearing objects referenced:

6' Steel sign rail N.86 W. 3.15'

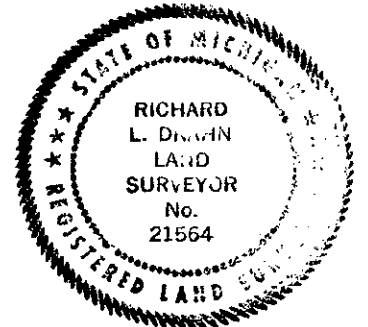

Signed by Richard L. Drahn

Date May 29, 1996

Surveyor's Michigan License No. 21564