

Register's Office }
 Gogebic County } ss.

LAND CORNER RECORDATION CERTIFICATE
 Filing Requirement of Act 74, Mich. P.A. 1970

Received for record the
26th day of MAY
 A. D. 2000 at 11:00 o'clock
10 a. m., and recorded in
 Liber 7 of CORNERS

For corners in

GOGEBIC

(County)

Located In:

Corner Code #

1. Public Land Survey

T46N R44W

J-5

T___ R___

T___ R___

T___ R___

S___ T___ R___

S___ T___ R___

S___ T___ R___

S___ T___ R___

SURVEY &
 REMONUMENTATION

JAN 05 2001

SECTION

page 3/9

Cheryl Ruppe
 Deputy Register of Deeds

Register of Deeds Stamp & File Number

4. Lot No. _____, Recorded Plat _____

5. Private Claims _____

Quarter Corner, Sections 11 & 14, T46N, R44W

I, John P. Goss, in a field survey on April 14, 2000 do hereby state that under requirements of P.A. 74, Michigan P.A. of 1970, the corner points mentioned in lines 1 and 2 above were in conformance with regulations and rules therefore as required in the current manual of survey instructions of the United States Department of the Interior, Bureau of Land Management or by a decree of a Court of Law and/or that the corner points mentioned in lines 3, 4 and 5 above were in conformance with the rules of the Michigan Board of Land Surveyors or by a Decree of a Court of Law, established, re-established, monumented, recovered, found as expressed below:

NOTE: Not more than 2 corners, all in the same town and range, may be recorded on this certificate.

	A	B	C	D	E	F	G	H	I	J	K	L	M
1													
2		6		5		4		3		2		1	
3													
4		7		8		9		10		11		12	
5													
6		10		17		16		15		14		13	
7													
8		19		20		21		22		23		24	
9													
10		30		29		28		27		26		25	
11													
12		31		32		33		34		35		36	
13													

A. Description of original monument and accessories and/or subsequent restoration:

Corner established by Austin Burt, on August 21, 1851.

Original bearing trees: Spruce 8" S 04° W 27 links (17.82 ft.)

Spruce 8" N 17° E 36 links (23.76 ft.)

Richard L. Drahn, 21564, on May 27, 1982, found corner position marked by a 3/4" x 1.7' iron pipe at the intersection of very old down fence lines, north, south, and west. Also the first bearing tree was a 10-16" spruce stump, decayed to below ground line. He set a 2" I.D. aluminum monument with a 3/4" cap, stamped to indicated the corner position. He established the following reference objects: Tamarack - N 19° W - 12.87 ft.; Red Pine - N 51° E - 10.25 ft.

B. Description of corner evidence found and/or method applied in restoring or reestablishing corner:

5" Red Pine - S 30° E - 5.29 ft. (Now down); 6' metal sign post - S 85° E - 2.11 ft. On March 15, 1983, he recorded said corner in Liber 2, page 392 of Land Corners.

Found Richard L. Drahn, monument and accessories.


Act 74 research on file.

FIELD GROUP APPROVED
Richard L. Drahn 05/24/00
 COUNTY SUPERVISOR

C. Description of monument for corner and accessories established to perpetuate locating the position of the corner:

From the found monument stamped to read: T.46 N., R.44 W.; 1/4; S-11, S-14; 1982; R.L.S. 21564: from which I established the following existing and new reference objects:

8" Tamarack N 19° W 13.02 ft. new nail
 8" Red Pine N 51° E 10.29 ft. new nail
 13" Red Pine S 67° E 10.11 ft.
 6' metal sign post S 85° E 2.11 ft. to face
 (All measurement taken to nail in side of tree)

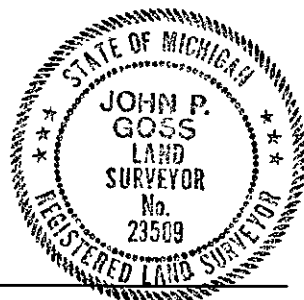

Signed by John P. Goss
 Surveyor's Michigan License No. 23509

Date April 14, 2000

U.S.F.S. No. J-19