

MAR 02 2000

SECTION

LAND CORNER RECORDATION CERTIFICATE  
Filing Requirement of Act 74, Mich. P.A. 1970

Register's Office }  
Gogebic County } ss.

For corners in

|                                       |   |               |
|---------------------------------------|---|---------------|
| <u>Gogebic</u><br>(County)            | Located In:                               | Corner Code # |
| 1. Public Land Survey Section 14      | T <u>46N</u> R <u>44W</u>                 | <u>J-7</u>    |
|                                       | T <u>    </u> R <u>    </u>               | <u>    </u>   |
|                                       | T <u>    </u> R <u>    </u>               | <u>    </u>   |
|                                       | T <u>    </u> R <u>    </u>               | <u>    </u>   |
| 2. Property Controlling<br>in Section | S <u>    </u> T <u>    </u> R <u>    </u> | <u>    </u>   |
|                                       | S <u>    </u> T <u>    </u> R <u>    </u> | <u>    </u>   |
| 3. Miscellaneous<br>Property in Sec.  | S <u>    </u> T <u>    </u> R <u>    </u> | <u>    </u>   |
|                                       | S <u>    </u> T <u>    </u> R <u>    </u> | <u>    </u>   |

Received for record the  
26<sup>th</sup> day of AUGUST  
A. D. 1999 at 1:35 o'clock  
P m., and recorded in  
Liber 7 of CORNERS  
on page 223.  
Ramona Collins Deputy  
Register of Deeds

Register of Deeds Stamp & File Number

4. Lot No. \_\_\_\_\_, Recorded Plat \_\_\_\_\_  
5. Private Claims \_\_\_\_\_  
Section corner common to sections 14 & 23

John R. Garske June 17, 99

I, \_\_\_\_\_, in a field survey on \_\_\_\_\_, 19\_\_\_\_ do hereby state that under requirements of P.A. 74, Michigan P.A. of 1970, the corner points mentioned in lines 1 and 2 above were in conformance with regulations and rules therefore as required in the current manual of survey instructions of the United States Department of the Interior, Bureau of Land Management or by a decree of a Court of Law and /or that the corner points mentioned in lines 3, 4 and 5 above were in conformance with the rules of the Michigan Board of Land Surveyors or by a Decree of a Court of Law; established, re-established, monumented, recovered, found as expressed below:

NOTE: Not more than 2 corners, all in the same town and range, may be recorded on this certificate.

|    |    |   |    |   |    |   |    |   |    |   |    |   |   |
|----|----|---|----|---|----|---|----|---|----|---|----|---|---|
|    | A  | B | C  | D | E  | F | G  | H | I  | J | K  | L | M |
| 1  |    |   |    |   |    |   |    |   |    |   |    |   |   |
| 2  | 6  |   | 5  |   | 4  |   | 3  |   | 2  |   | 1  |   |   |
| 3  |    |   |    |   |    |   |    |   |    |   |    |   |   |
| 4  | 7  |   | 8  |   | 9  |   | 10 |   | 11 |   | 12 |   |   |
| 5  |    |   |    |   |    |   |    |   |    |   |    |   |   |
| 6  | 18 |   | 17 |   | 16 |   | 15 |   | 14 |   | 13 |   |   |
| 7  |    |   |    |   |    |   |    |   |    |   |    |   |   |
| 8  | 19 |   | 20 |   | 21 |   | 22 |   | 23 |   | 24 |   |   |
| 9  |    |   |    |   |    |   |    |   |    |   |    |   |   |
| 10 | 30 |   | 29 |   | 28 |   | 27 |   | 26 |   | 25 |   |   |
| 11 |    |   |    |   |    |   |    |   |    |   |    |   |   |
| 12 | 31 |   | 32 |   | 33 |   | 34 |   | 35 |   | 36 |   |   |
| 13 |    |   |    |   |    |   |    |   |    |   |    |   |   |

A. Description of original monument and accessories and/or subsequent restoration:

Original survey by Austin Burt, D.S. in July 1851  
Original Bearing Trees:  
Cedar 8" S20°E 17 links  
Cedar 10" N41°W 22 links  
Corner restored in 1983 by Richard Drahn, RLS #21564, from the remains of the original bearing trees. Recorded L2 page 394. He set a 2" concrete filled pipe with a 3 1/4" dia. aluminum cap stamped from which:  
9" white spruce N28°E 32.62 feet  
12" aspen N54°E 50.62 feet  
10" twin white spruce S60°E 13.54 feet  
Metal sign post N45°W 2.4 feet

B. Description of corner evidence found and/or method applied in restoring or reestablishing corner:


I found the monument as described above. I set nails in the trees and recorded new ties as noted below.

(Research on file)

DEED GROUP APPROVED  
Richard P. Drahn 8/24/99  
COUNTY REGISTER

C. Description of monument for corner and accessories established to perpetuate locating the position of the corner:

Established the following witnesses:  
Metal sign post N45°W 2.44 feet  
18" white spruce N30°E 32.91 feet  
20" aspen N59°E 50.65 feet  
18" twin white spruce S53°E 13.49 feet

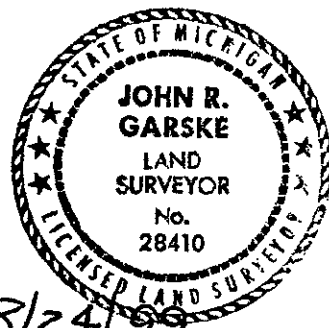

Signed by John R. Garske  
Surveyor's Michigan License No. 28410

Date 8/24/99