

**LAND CORNER RECORDATION CERTIFICATE**  
Filing Requirement of Act 74, Mich. P.A. 1970

Register's Office }  
Gogebic County } ss.

For corners in

GOGEBIC

(County)

Located In:

Corner Code #

1. Public Land Survey

T 46 N 44 W      K-6

T \_\_\_ R \_\_\_

T \_\_\_ R \_\_\_

T \_\_\_ R \_\_\_

2. Property Controlling in Section

S \_\_\_ T \_\_\_ R \_\_\_

S \_\_\_ T \_\_\_ R \_\_\_

3. Miscellaneous Property in Sec.

S \_\_\_ T \_\_\_ R \_\_\_

S \_\_\_ T \_\_\_ R \_\_\_

**SURVEY &  
MONUMENTATION**

**JAN 05 2001**

**SECTION**

Received for record the  
26<sup>TH</sup> day of MAY

A. D. 19 00 at 11:10 o'clock

A M., and recorded in

Liber 7 of CORNERS

\* Page 326

*Cheyl Rupp*  
Dep. Register of Deeds

Register of Deeds Stamp & File Number

4. Lot No. \_\_\_\_\_, Recorded Plat \_\_\_\_\_

5. Private Claims \_\_\_\_\_

Quarter Corner, Sections 13 & 14, T46N, R44W

I, John P. Goss, in a field survey on April 14, 2000 do hereby state that under requirements of P.A. 74, Michigan P.A. of 1970, the corner points mentioned in lines 1 and 2 above were in conformance with regulations and rules therefore as required in the current manual of survey instructions of the United States Department of the Interior, Bureau of Land Management or by a decree of a Court of Law and for that the corner points mentioned in lines 3, 4 and 5 above were in conformance with the rules of the Michigan Board of Land Surveyors or by a Decree of a Court of Law; established, re-established, monumented, recovered, found as expressed below:

A	B	C	D	E	F	G	H	I	J	K	L	M
1												
2	6		5		4		3		2		1	
3												
4	7		8		9		10		11		12	
5												
6	18		17		16		15		14		13	
7												
8	19		20		21		22		23		24	
9												
10	30		29		28		27		26		25	
11												
12	31		32		33		34		35		36	
13												

NOTE: Not more than 2 corners, all in the same town and range, may be recorded on this certificate.

A. Description of original monument and accessories and/or subsequent restoration:

Corner established by Austin Burt, on August 22, 1851.

Original bearing trees: Cedar 6" S 25° E 30 links (19.80 ft.)

Spruce 8" N 73° W 28 links (18.48 ft.)

Richard L. Drahn, 21564, on October 5, 1981, found no original evidence. Corner position marked by a 1/2" by 1.2' iron pipe, at intersection of a very old and downed fence line north, south and west. He set a 2" I.D. aluminum monument with a 3/4" aluminum cap, stamped to indicated the corner position. He established the following reference objects: White Spruce - N 20° E - 29.75 ft.; 10" Yellow Birch S 62° E - 57.52 ft.; 8" Black Ash - S 43° W - 27.21 ft.; 6' metal sign post-

B. Description of corner evidence found and/or method applied in restoring or reestablishing corner: N 50° E - 2.28 ft. On March 10, 1982, he recorded said corner in Liber 2, page 238 Land Corners.

Found Richard L. Drahn, monument and accessories.

Act 74 research on file.

**NEER GROUP APPROVED**

*Richard L. Drahn 05/24/00*


**COUNTY MONUMENTATION**

C. Description of monument for corner and accessories established to perpetuate locating the position of the corner:

From the found monument, stamped to read: T.46 N., R.44 W.; 1/4; S-13, S-14; 1981; R.L.S. 21564: from which I established the following existing and new reference objects:

18" White Spruce	N 20° E	29.75 ft.
12" Yellow Birch	S 62° E	57.60 ft. new nail
11" Black Ash	S 43° W	27.25 ft. new nail
8" Balsam	N 45° W	15.50 ft.
6' metal sign post	N 50° E	2.28 ft. to face

(All measurement taken to nail in side of tree)

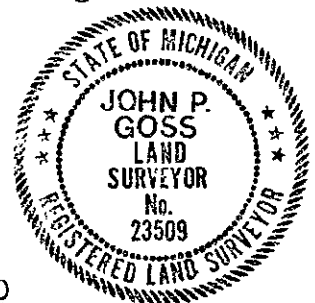

Signed by John P. Goss

Date April 14, 2000

Surveyor's Michigan License No. 23509

U.S.F.S. No. L-21