

LAND CORNER RECORDATION CERTIFICATE
Filing Requirement of Act 74, Mich. P.A. 1970

Register's Office }
Gogebic County } ss.

For corners in

GOGEBIC

(County)

Located in:

Corner Code #

1. Public Land Survey

T46NR 44W

L-7

T___ R___

T___ R___

T___ R___

S___ T___ R___

S___ T___ R___

S___ T___ R___

S___ T___ R___

SURVEY &
REMONUMENTATION

JAN 05 2001

SECTION

Received for record the
26TH day of MAY
A. D. 2000 at 11:10 o'clock
8 m., and recorded in
Liber 7 of CORNERS

page 331

Cheer Ruppel
Def. Register of Deeds

Register of Deeds Stamp & File Number

4. Lot No. _____, Recorded Plat _____

5. Private Claims _____

Quaret Corner, Sections 13 & 24, T46N, R44W

I, John P. Goss, in a field survey on April 24, 2000 do hereby state that under requirements of P.A. 74, Michigan P.A. of 1970, the corner points mentioned in lines 1 and 2 above were in conformance with regulations and rules therefore as required in the current manual of survey instructions of the United States Department of the Interior, Bureau of Land Management or by a decree of a Court of Law and/or that the corner points mentioned in lines 3, 4 and 5 above were in conformance with the rules of the Michigan Board of Land Surveyors or by a Decree of a Court of Law; established, re-established, monumented, recovered, found as expressed below:

NOTE: Not more than 2 corners, all in the same town and range, may be recorded on this certificate.

	A	B	C	D	E	F	G	H	I	J	K	L	M
1													
2	6		5		4		3		2		1		
3													
4	7		8		9		10		11		12		
5													
6	18		17		16		15		14		13		
7													
8	19		20		21		22		23		24		
9													
10	30		29		28		27		26		25		
11													
12	31		32		33		34		35		36		
13													

A. Description of original monument and accessories and/or subsequent restoration:

Corner established by Austin Burt, on July 17, 1851.

Original bearing trees: Fir 10" S 10° W 17 links (11.22 ft.)
Fir 8" N 40° E 45 links (29.70 ft.)

Richard L. Drahn, 21564; on Dec. 1, 1982, re-established corner position on line between and equal distance from the Southeast and Southwest section corners of Section 13. He set a 3/4" by 8' long aluminum rod with a 3/4" cap; stamped to indicate the corner position. He established the following reference objects:
12" Y. Birch - N 05° E - 9.92 ft.; 9" Cedar - N 57° W - 40.40 ft.; 12" B. Ash - S 24° E - 34.00 ft.; 6' metal sign post - S 11° W - 1.11 ft.

B. Description of corner evidence found and/or method applied in restoring or reestablishing corner:

On March 15, 1983, he recorded said corner in Liber 2, Page 404 of Land Corners

Found Richard L. Drahn, monument and accessories.

Act 74 research on file.

PEER GROUP APPROVED

Richard L. Drahn 05/24/00


COUNTY Gogebic STATE MI

C. Description of monument for corner and accessories established to perpetuate locating the position of the corner:

From the found monument stamped to read: T.46 N., R.44 W.; 1/4; S-13, S-24; 1982, R.L.S. 21564; from which I established the following existing and new reference objects:

15" Yellow Birch	N 05° E	9.92 ft.
13" Cedar	N 57° W	30.40 ft.
16" Black Ash	S 24° E	33.98 ft.
7" Black Ash	N 76° E	8.04 ft.
6' metal sign post	S 11° W	1.11 ft. to face

(All measurement taken to nail in side of tree)

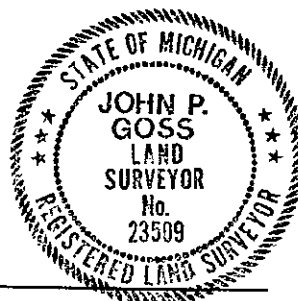

Signed by John P. Goss

Date April 24, 2000

Surveyor's Michigan License No. 23509

U.S.F.S. No. N-23