

SURVEY & REMONUMENTATION

AUG 08 1997

COMMISSION

LAND CORNER RECORDATION CERTIFICATE Filing Requirement of Act 74, Mich. P.A. 1970

Register's Office } ss.
Gogebic County }

For corners in

<u>Gogebic</u> (County)	Located In:	Corner Code #
1. Public Land Survey	T46NR 44W	L-9
	T ___ R ___	_____
	T ___ R ___	_____
	T ___ R ___	_____
2. Property Controlling in Section	S ___ T ___ R ___	_____
	S ___ T ___ R ___	_____
3. Miscellaneous Property in Sec.	S ___ T ___ R ___	_____
	S ___ T ___ R ___	_____

Received for record the
16TH day of JULY
A. D. 1997 at 1:40 o'clock
P m., and recorded in
Liber 6 of CORNERS
on page 169
Colleen M. Hinkel
Deputy Register of Deeds

Register of Deeds Stamp & File Number

4. Lot No. _____, Recorded Plat _____
5. Private Claims _____

1/4 cor. comm. to sec's 24 & 25

I, John P. Goss, in a field survey on June 13 19 97 do hereby state that under requirements of P.A. 74, Michigan P.A. of 1970, the corner points mentioned in lines 1 and 2 above were in conformance with regulations and rules therefore as required in the current manual of survey instructions of the United States Department of the Interior, Bureau of Land Management or by a decree of a Court of Law and/or that the corner points mentioned in lines 3, 4 and 5 above were in conformance with the rules of the Michigan Board of Land Surveyors or by a Decree of a Court of Law; established, re-established, monumented, recovered, found as expressed below:

NOTE: Not more than 2 corners, all in the same town and range, may be recorded on this certificate.

	A	B	C	D	E	F	G	H	I	J	K	L	M
1													
2	6		5		4		3		2		1		
3													
4	7		8		9		10		11		12		
5													
6	18		17		16		15		14		13		
7													
8	19		20		21		22		23		24		
9													
10	30		29		28		27		26		25		
11													
12	31		32		33		34		35		36		
13													

A. Description of original monument and accessories and/or subsequent restoration:

Original corner established by Austin Burt on Aug. 25, 1851. Set a post.
Original bearing trees: Sugar 7" S 49° E 21 links
Hemlock 8" N 51° W 22 links

Richard Drahn, RLS, on May 14, 1975. Restored corner position at record bearing and distance from the remains of the two original bearing trees. The first a large stump hole with fragments of Sugar Maple wood. The second one is now a 12"-14" Hemlock stump, decayed to the ground line. Corner position verified further by retracement measurement to recovered line trees. He set a 2" I.P. with 3" bronze tablet marked to indicate the corner position, with the follows

B. Description of corner evidence found and/or method applied in restoring or reestablishing corner:

reference objects: He recorded in Liber 1, page 159 of Land corners.
7" Sugar Maple N 78° E 30.1'
6" Sugar Maple N 30° E 36.0'
8" Sugar Maple N 20° W 7.8'
7" Metal Sign Post North 2.1'

PEER GROUP APPROVED
Richard P. Drahn 7/15/97
COUNTY REPRESENTATIVE

Found R. Drahn 2" iron pipe with 3" bronze tablet. It checked with R. Drahn witnesses. I updated the accessories as noted below to state and county specification.

Act 74 research on file.

C. Description of monument for corner and accessories established to perpetuate locating the position of the corner:


From the 2" I.D. iron pipe with 3" circular bronze tablet which reads: T.46 N., R.44 W.; 1/4; S-24, S-25; R.L.S. 21564; 1975. I established the following existing and new bearing trees and reference objects.

9" Sugar Maple (dead) N 78° E 30.07'
8" Sugar Maple N 30° E 35.55'
10" Sugar Maple N 20° W 7.84'
7" Metal Sign Post N 12° E 2.1' (to face of post)
11" Sugar Maple S 32° E 16.15'
6" Rail & Sign S 50° W 1.9' (to face of rail)

(measurement to nail in side of tree)

Signed by John P. Goss
Surveyor's Michigan License No. 23509

Date June 14, 1997

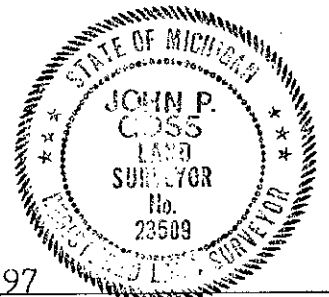

Fed. No. R-23