

NOV 12 1997

COMMISSION

LAND CORNER RECORDATION CERTIFICATE
Filing Requirement of Act 74, Mich. P.A. 1970

Register's Office
Gogebic County ss.

For corners in

Gogebic

(County)

Located In:

Corner Code #

1. Public Land Survey

T.46N R.44W

L-11

T. R.

T. R.

T. R.

2. Property Controlling in Section

S. T. R.

S. T. R.

3. Miscellaneous Property in Sec.

S. T. R.

S. T. R.

4. Lot No. , Recorded Plat

5. Private Claims

Received for record the
9th day of OCTOBER

A. D. 1997 at 10:50 o'clock

A. m., and recorded in

Liber 6 of CORNERS

page 218

Kamena Collins, Deputy

Register of Deeds

Register of Deeds Stamp & File Number

Grid table with columns A-L and rows 1-13. A dot is marked at row 11, column L.

I, John P. Goss, in a field survey on Oct. 7, 1997 do hereby state that under requirements of P.A. 74, Michigan P.A. of 1970, the corner points mentioned in lines 1 and 2 above were in conformance with regulations and rules therefore as required in the current manual of survey instructions of the United States Department of the Interior, Bureau of Land Management or by a decree of a Court of Law and/or that the corner points mentioned in lines 3, 4 and 5 above were in conformance with the rules of the Michigan Board of Land Surveyors or by a Decree of a Court of Law; established, re-established, monumented, recovered, found as expressed below:

NOTE: Not more than 2 corners, all in the same town and range, may be recorded on this certificate.

1/4 cor. comm. to sec's. 25 & 36

A. Description of original monument and accessories and/or subsequent restoration:

Original corner established by Austin Purt on Aug. 23, 1851.

Original bearing trees: Hemlock 10" N 35° W 22 links (14.52')

Y. Birch 12" S 09° E 23 links (15.18')

Corner position re established by Richard Drahn, RLS, on May 14, 1975. At record bearing and distance from the remains of the two original bearing trees. He set a 2 1/2" iron pipe with 3" circular bronze tablet stamped to indicated the corner position. He established the following references: 10" Spruce - N 25° W- 7.6'; 5" Red Maple - S 43° E - 8.4'; 9" Balsam ( Now stump with blazed & scribing visible)- 10.2'; 7' Metal sign post - South - 2.5'.

B. Description of corner evidence found and/or method applied in restoring or reestablishing corner:

Rerecorded said corner in Liber 1, page 154 of Land Corners for Gogebic County.

Found Richard Drahn corner monument and witnesses.

I updated the corner monument and accessories as noted below to state and county specification.

Act 74 research on file.


C. Description of monument for corner and accessories established to perpetuate locating the position of the corner:

From the 2 1/2" iron pipe with 3" circular bronze tablet which read: T.46 N, R.44 W. 1/4; S-25, S-36; R.L.S. 21564; 1975, I established the following existing and new bearing trees and reference object.

- 15" Spruce N 25° W 7.58'
9" Red Maple S 43° E 8.44'
7' Metal sign Post South 2.5' (to face)
8" Red Maple N 82° E 14.09'
6" Red Maple S 65° W 15.88'

(Measurement to nail in side of tree)

PEER GROUP APPROVED
Richard R. Drahn 10/8/97
COUNTY REPRESENTATIVE

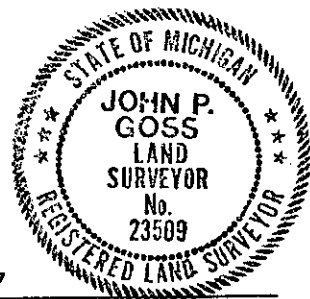

Signed by John P. Goss

Date October 7, 1997

Surveyor's Michigan License No. 23509

Fee. No. V-23