SURVEY & REMONUMENTATION

NOV 1 2 1997

COMMISSION

LAND CORNER RECORDATION CERTIFICATE
Filing Requirement of Act 74, Mich. P.A. 1970

Register's Office } ss.
Gogebic County }

Received for record the 9th day of OCTOBER A. D. 1997 at 10:50 o'clock A m., and recorded in Liber 6 of CORNERS page 217.

Ramona Collins Deputy
Register of Deeds

Register of Deeds Stamp & File Number

For corners in

Gogebic
(County)

	Located In:	Corner Code #
1. Public Land Survey	T46NR 43W	A-11
	T46NR 44W	M-11
	T___ R___	
	T___ R___	
2. Property Controlling in Section	S___ T___ R___	
	S___ T___ R___	
3. Miscellaneous Property in Sec.	S___ T___ R___	
	S___ T___ R___	

4. Lot No. _____, Recorded Plat _____
5. Private Claims _____

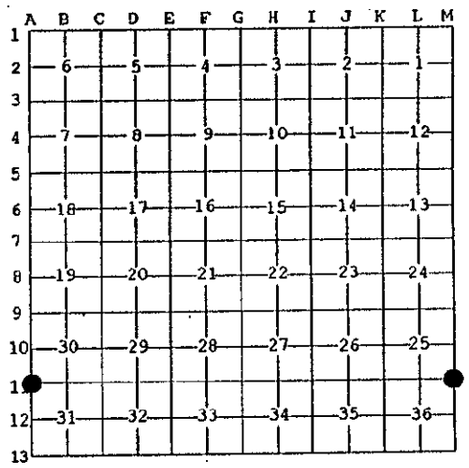

I, John P. Goss, in a field survey on Oct. 1, 1997 do hereby state that under requirements of P.A. 74, Michigan P.A. of 1970, the corner points mentioned in lines 1 and 2 above were in conformance with regulations and rules therefore as required in the current manual of survey instructions of the United States Department of the Interior, Bureau of Land Management or by a decree of a Court of Law and /or that the corner points mentioned in lines 3, 4 and 5 above were in conformance with the rules of the Michigan Board of Land Surveyors or by a Decree of a Court of Law; established, re-established, monumented, recovered, found as expressed below:

NOTE: Not more than 2 corners, all in the same town and range, may be recorded on this certificate.

S.C. comm. to sec's. 25,36,30 & 31

A. Description of original monument and accessories and/or subsequent restoration:
Original corner established by Austin Burt on Aug. 8, 1847.
Original bearing trees: 1. Cedar 10" S 39° W 26 links
2. Y. Birch 10" S 38° E 34 links
3. Fir 12" S 45° E 27 links
4. Fir. 12" N 38° W 12 links.

On Nov. 4, 1974, Richard Drahn, restored corner position at record distance and bearings from remains (stump hole) of original bearing trees. He set a 2½" iron pipe with 3" bronze cap stamped to indicated corner position. He established the following reference objects: 5" R. Maple - N 23° E - 21.5; 5" R. Maple - N 66° E - 25.1'; 5" S. Maple - S 36° W - 37.3'; 4"x4"x7' cedar sign post - N 61° E - 2.9'.

He recorded said corner in Liber 1, page 276 of Land corner for Gogebic County.

Found Richard Drahn corner monument and witnesses.

I updated the corner monument and accessories as noted below to state and county specification.

Act 74 research on file.

PEER GROUP APPROVED
Richard R. Drahn 10/8/97
COUNTY REPRESENTATIVE

B. Description of corner evidence found and/or method applied in restoring or reestablishing corner:

C. Description of monument for corner and accessories established to perpetuate locating the position of the corner:
From the 2½" iron pipe and 3" bronze cap which read: T.46 N., R.43-44 W.; S-25, S-36, S-30, S-31; R.L.S. 21564; 1974, from which I established existing bearing trees and existing and new reference objects.

8" Red Maple	N 23° E	21.48'
7" Red Maple	N 66° E	25.12'
8" Sugar Maple	S 36° W	37.20'
4"x4"x7' Cedar sign post	N 61° E	2.70' (to face)
6' Rail & Sign	North	1.26' (to face)

(all measurement to nail in side of tree)

STATE OF MICHIGAN
JOHN P. GOSS
LAND SURVEYOR
No. 23509
REGISTERED LAND SURVEYOR

Signed by John P Goss

Date October 1, 1997

Surveyor's Michigan License No. 23509

Fed. No. V-25

FORM APPROVED BY MICHIGAN STATE BOARD OF PROFESSIONAL SURVEYORS, JAN. 28, 1971
REVISED MAY 14,1975
REVISED JAN., 1983
REVISED OCT., 1995