

SURVEY &
REMONUMENTATION

COMP 3/3/95-4
COMP 5/10/95-4


JAN 20 1999

LAND CORNER MONUMENTS

SECTION

T. 46 N., R. 44 W.

MARENISCO TOWNSHIP

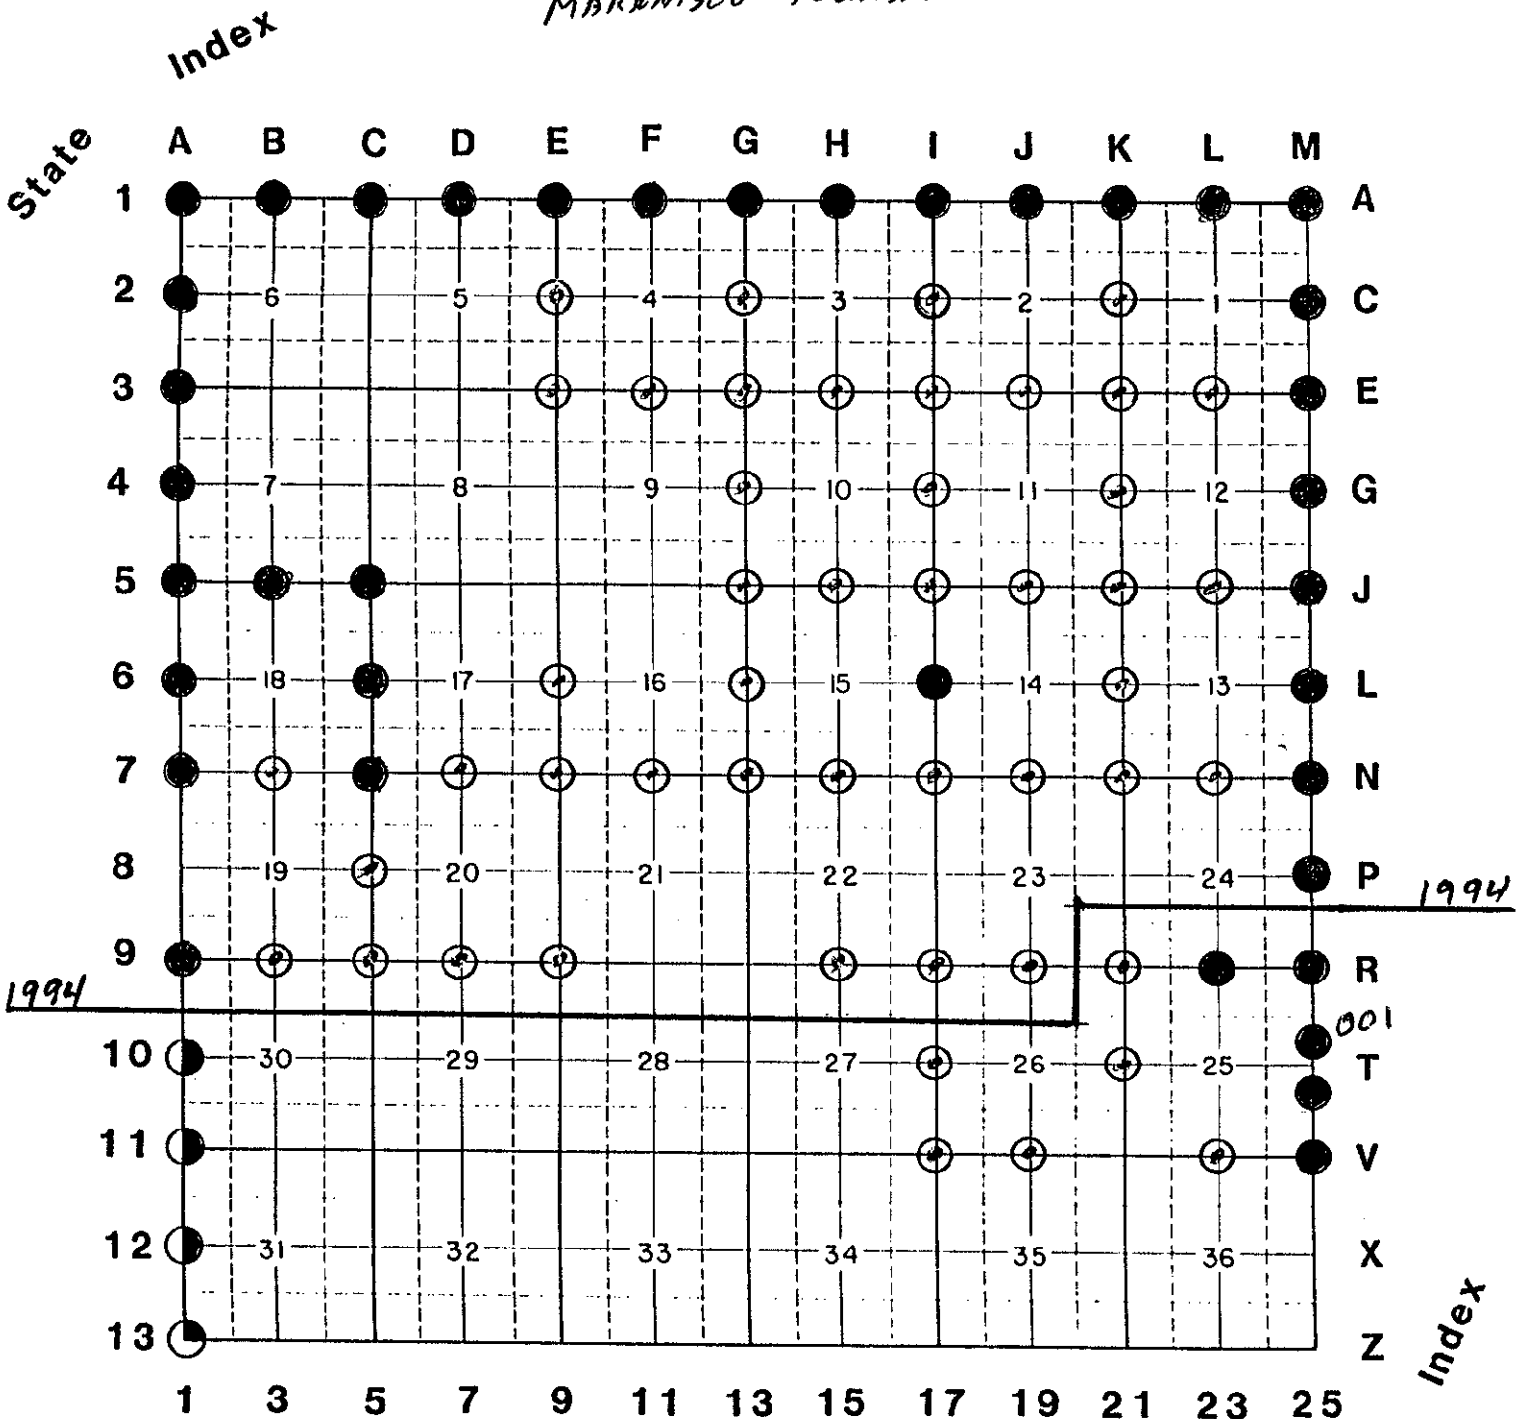

AS OF 12/31/98

LEGEND

- GLO Corners researched
- ⊙ GLO Corners monumented, not approved
- ⊗ GLO Corners approved
- GLO Corners approved & reported to State

T. 46 N., R. 44 W.