SURVEY & RECORDATION

DEC 15 1998

LAND CORNER RECORDATION CERTIFICATE

Filing Requirement of Act 74, Mich. P.A. 1970

Register's Office } ss.
Gogebic County

Received for record the 30th day of October A. D. 19 98 at 9:05 o'clock A m., and recorded in Liber 7 of Corners on page 65.

Ramona Collins, Deputy
Register of Deeds

Register of Deeds Stamp & File Number

For corners in SECTION

Gogebic (County)

	Located In:	Corner Code #
1. Public Land Survey	T 46N R 45W	A-3
	T ___ R ___	
	T ___ R ___	
	T 46N R 46W	M-3
2. Property Controlling	S ___ T ___ R ___	
in Section	S ___ T ___ R ___	
3. Miscellaneous	S ___ T ___ R ___	
Property in Sec.	S ___ T ___ R ___	

4. Lot No. _____ , Recorded Plat _____

5. Private Claims _____

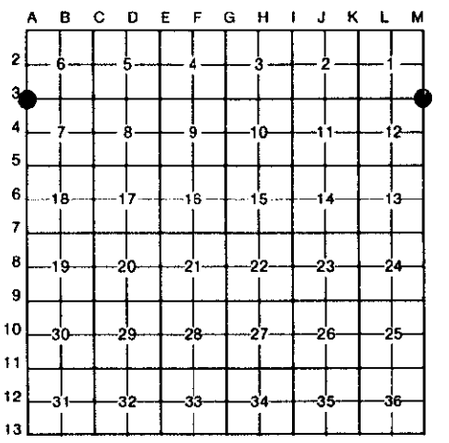

Section Corner 6, 7, 1 & 12; T.46 N., R.45-46 W.

I, Richard L. Drahn in a field survey on October 2, _____, 19 98, do hereby certify that under requirements of P.A. 74, Michigan P.A. of 1970, the corner points mentioned in lines 1 and 2 above were in conformance with regulations and rules therefore as required in the current manual of survey instructions of the United States Department of the Interior, Bureau of Land Management or by a decree of a Court of Law and/or that the corner points mentioned in lines 3, 4 and 5 above were in conformance with the rules of the Michigan Board of Land Surveyors or by a Decree of a Court of Law; established, re-established, monumented, re-monumented, recovered, found as expressed below:

NOTE: Not more than 4 corners, all in the same town and range, may be recorded on this certificate.

A. Description of original monument and accessories and/or subsequent restoration:

Corner established by John Burt on (/1/1847. Original B.T.s --- Cedar 12 " S.70 E. 21 links (13.86') --- Cedar 10" N.50 W. 10 links (6.60') --- Cedar 14" S.56 W. 47 links (31.02') --- B. Ash N.43 E. 8 links (5.28') ---

Linn and Campbell, on 7/24/35 recovered a B.T. in poorcondition and placed a location poster on the west side of a 9" Black Ash.

B. Description of corner evidence found and/or method applied in restoring or reestablishing corner:

Restored corner position at record bearing and distance from the remains of the three Cedar bearing trees. The first is a 17" near dead Cedar with portions of scribing still visible. (names and dates on tree to 1895). The second one is a downed 12-16" Cedar with GLO blaze overgrowth. The third one is now a series of root holes with fragments of Cedar wood. No evidence remains of the original Black Ash bearing tree. 1935 tag (unreadable) bears S.32 E. 6.6', on a 13" Black Ash.

Corner research on file with Gogebic County records.

PEER GROUP APPROVED
Richard L. Drahn 10/27/98
COUNTY REPRESENTATIVE

C. Description of monument for corner and accessories established to perpetuate locating the position of the corner:

At the corner position I set a 3/4" X 8' aluminum rod with a 3¼" stamped aluminum cap and the following new bearing objects:

11"	Cedar	S.86 E.	34.72'
8"	Cedar	N.17 E.	20.13'
8"	Yellow Birch	S.38 W.	28.62'
6'	Steel sign rail	N.28 W.	2.04'

A 3/4" iron pipe and quard post bears S.35 E., 20.5'

STATE OF MICHIGAN
RICHARD L. DRAHN
LAND SURVEYOR
No. 21564
REGISTERED LAND SURVEYOR

Signed by Richard L. Drahn Date October 6, 1998

Surveyor's Michigan License No. 21564

USFS E-1

FORM APPROVED BY MICHIGAN STATE BOARD OF LAND SURVEYORS, JAN. 28, 1971
REVISED MAY 14, 1975
REVISED JAN., 1983