

MAR 02 2000

LAND CORNER RECORDATION CERTIFICATE
Filing Requirement of Act 74, Mich. P.A. 1970

Register's Office } ss.
Gogebic County }

For corners in SECTION

Received for record the
12 day of MAY
A. D. 1999 at 10:30 o'clock
A. m., and recorded in
Liber 7 of CORNERS
on page 141
Ramona Collins, Deputy
Register of Deeds

Gogebic (County) Located In: Corner Code #

1. Public Land Survey T 46N R 45W A-12
T R
T R
T 46N R 46W M-12

2. Property Controlling S T R
in Section S T R

3. Miscellaneous S T R
Property in Sec. S T R

Register of Deeds Stamp & File Number

4. Lot No. _____, Recorded Plat _____
5. Private Claims _____

1/4 Corner 31 & 36; T.46 N., R.45-46 W.

Richard L. Drahn in a field survey on March 17, 1999, do hereby certify that under requirements of P.A. 74, Michigan P.A. of 1970, the corner points mentioned in lines 1 and 2 above were in conformance with regulations and rules therefore as required in the current manual of survey instructions of the United States Department of the Interior, Bureau of Land Management or by a decree of a Court of Law and/or that the corner points mentioned in lines 3, 4 and 5 above were in conformance with the rules of the Michigan Board of Land Surveyors or by a Decree of a Court of Law; established, re-established, monumented, re-monumented, recovered, found as expressed below:

A	B	C	D	E	F	G	H	I	J	K	L	M
2	6	5	4	3	2							
3												
4	7	8	9	10	11	12						
5												
6	18	17	16	15	14	13						
7												
8	19	20	21	22	23	24						
9												
10	30	29	28	27	26	25						
11												
12	31	32	33	34	35	36						
13												

NOTE: Not more than 4 corners, all in the same town and range, may be recorded on this certificate.

A. Description of original monument and accessories and/or subsequent restoration:

Corner established by John Burt on 9/1/1847. Original B.T.s --- Tamarack 18" S.61 E. 79 links (52.14') --- Tamarack 20" N.49 E. 40 links (26.4') ---

B. Description of corner evidence found and/or method applied in restoring or reestablishing corner:

Restored corner position at record bearing and distance from the remains of the two original bearing trees. The first is a very large, decayed Tamarack stump that positions the corner at the stream edge. The second one is now a very large windthrown, vegetation-free depression.

Corner research on file with Gogebic County records.


C. Description of monument for corner and accessories established to perpetuate locating the position of the corner:

At the corner position I set a 3/4" X 8' long aluminum rod with a 3/4" stamped aluminum cap and the following new bearing objects:

10"	Cedar	N.18 E.	39.12'
9"	Cedar	N.87 E.	68.94'
12"	Cedar	N.70 E.	61.58'
6'	Steel sign rail	East	3.14'

PEER GROUP APPROVED

Richard L. Drahn 5/11/99
COUNTY REGISTERED

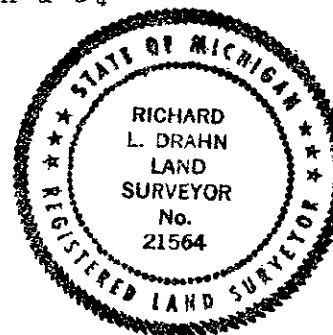

Signed by Richard L. Drahn Date March 19, 1999

Surveyor's Michigan License No. 21564