

**SURVEY & REMONUM TATION**

AUG 08 1997

COMMISSION

**LAND CORNER RECORDATION CERTIFICATE**  
Filing Requirement of Act 74, Mich. P.A. 1970

Register's Office }  
Gogebic County } ss.

For corners in

Gogebic  
(County)

Located In: Corner Code #

- |                                    |                      |                 |
|------------------------------------|----------------------|-----------------|
| 1. Public Land Survey              | T46NR 44W            | A-1             |
|                                    | T47NR 44W            | A-13            |
|                                    | <del>T46NR 45W</del> | <del>M-13</del> |
|                                    | T47NR 45W            | M-13            |
| 2. Property Controlling in Section | S ___ T ___ R ___    | ___             |
| 3. Miscellaneous Property in Sec.  | S ___ T ___ R ___    | ___             |

Received for record the  
13<sup>th</sup> day of MAY  
A. D. 1997 at 2:10 o'clock  
P m., and recorded in  
Lib 6 of CORNERS  
pp. 125  
Ramona Collins, Deputy  
Register of Deeds


Register of Deeds Stamp & File Number

4. Lot No. \_\_\_\_\_, Recorded Plat \_\_\_\_\_

5. Private Claims \_\_\_\_\_  
Sec. cor, comm. to sec's. S-36,S-31,S-1,S-6

I, John P. Goss, in a field survey on May 6, 1997 do hereby state that under requirements of P.A. 74, Michigan P.A. of 1970, the corner points mentioned in lines 1 and 2 above were in conformance with regulations and rules therefore as required in the current manual of survey instructions of the United States Department of the Interior, Bureau of Land Management or by a decree of a Court of Law and /or that the corner points mentioned in lines 3, 4 and 5 above were in conformance with the rules of the Michigan Board of Land Surveyors or by a Decree of a Court of Law; established, re-established, monumented, recovered, found as expressed below:

NOTE: Not more than 2 corners, all in the same town and range, may be recorded on this certificate.

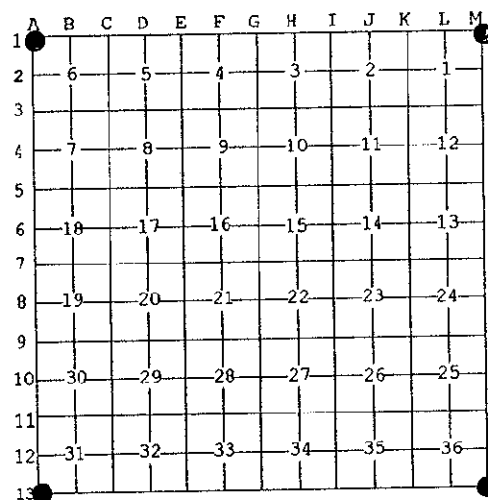

A. Description of original monument and accessories and/or subsequent restoration:

Original corner established by Austin Burt in 1847. Set Cedar post.  
Original bearing trees: Fir 8" S 40° E 24 links  
Cedar 14" N 44° W 3 links

On October 1, 1970, Donald Lappala, RLS, restored corner position at record bearing and distances from the Cedar B.T. He set a 2 1/2" iron pipe with 3" bronze table which read: T 46-47 N; R 44-45 W; S-36,S-31,S-1,S-6; R.L.S. 12585; 1970. He recorded said corner in Forest Service Liber for land corners in Register of Deeds Office for Gogebic County, from which he established the following new blazed and scribed bearing trees: 6" Y. Birch - N 88° W - 31.9'; 5" Cedar -

B. Description of corner evidence found and/or method applied in restoring or reestablishing corner:

N 07° W - 17.4'; 10" Y. Birch - S 06° W - 42.3'.  
In 1985 a 4" x 4" post - S 40° E - 3 feet was added.

Found the monument and bearing trees as described above.

Act 74 research on file.

PEER GROUP APPROVED  
Richard L. Deahn 5/12/97  
COUNTY REPRESENTATIVE

C. Description of monument for corner and accessories established to perpetuate locating the position of the corner:

From the monument, I established the existing and new bearing trees and reference objects:

- |                  |         |         |
|------------------|---------|---------|
| 9" Yellow Birch  | N 88° W | 31.94'  |
| 7" Cedar         | N 07° W | 17.42'  |
| 12" Yellow Birch | S 06° W | 42.25'  |
| 4"x4" wood Post  | S 40° E | 3 ft.   |
| 7" Yellow Birch  | N 73° E | 13.86'  |
| 6' Rail & sign   | N 33° E | 2.7 ft. |

(All measurement taken to a nail in side of tree)

Signed by John P. Goss  
Surveyor's Michigan License No. 23509

Date May 6, 1997

Fed. No. Z-25

