

SEP 08 1998

SECTION

LAND CORNER RECORDATION CERTIFICATE
Filing Requirement of Act 74, Mich. P.A. 1970

For corners in

Gogebic
 (County)

Located In: Corner Code #

- | | | |
|------------------------------------|-------------------------|------------|
| 1. Public Land Survey | T 46N R 44W | A-9 |
| | T _____ R _____ | _____ |
| | T _____ R _____ | _____ |
| | <u>T 46N R 45W</u> | <u>M-9</u> |
| | T _____ R _____ | _____ |
| 2. Property Controlling in Section | S _____ T _____ R _____ | _____ |
| | S _____ T _____ R _____ | _____ |
| 3. Miscellaneous Property in Sec. | S _____ T _____ R _____ | _____ |
| | S _____ T _____ R _____ | _____ |

Register's Office }
 Gogebic County } ss.

Received for record the
20th day of AUGUST
 A. D. 1998 at 1:15 o'clock
P m., and recorded in
Liber 7 of CORNERS

page 40
Ramona Collins Deputy
 Register of Deeds

Register of Deeds Stamp & File Number

4. Lot No. _____, Recorded Plat _____
 5. Private Claims _____

Section Corner 19, 30, 24 & 25; T.46 N., R.44-45 W.

Richard L. Drahn, in a field survey on August 4, 1998, do hereby certify that under requirements of P.A. 74, Michigan P.A. of 1970, the corner points mentioned in lines 1 and 2 above were in conformance with regulations and rules therefore as required in the current manual of survey instructions of the United States Department of the Interior, Bureau of Land Management or by a decree of a Court of Law and/or that the corner points mentioned in lines 3, 4 and 5 above were in conformance with the rules of the Michigan Board of Land Surveyors or by a Decree of a Court of Law; established, re-established, monumented, re-monumented, recovered, found as expressed below:

	A	B	C	D	E	F	G	H	I	J	K	L	M
2	6	5	4	3	2								
3													
4	7	8	9	10	11	12							
5													
6	18	17	16	15	14	13							
7													
8	19	20	21	22	23	24							
9													
10	30	29	28	27	26	25							
11													
12	31	32	33	34	35	36							
13													

NOTE: Not more than 4 corners, all in the same town and range, may be recorded on this certificate.

A. Description of original monument and accessories and/or subsequent restoration:

Corner established by Austin Burt on 8/30/1847. Original B.T.s --- Cedar 12" S.65 E. 19 links (12.54') --- Cedar 10" N.85 W. 13 links (8.58') --- Hemlock 14" S.28 W. 24 links (15.84') --- Cedar 10" N.38 E. 9 links (5.94')
 R.G. Campbell on 8/29/35 recovered the NE Cedar still scribed.

Richard L. Drahn, RLS 21564 on 4/18/83 found the remains of all four B.T.s, the NW one had reverse impressions of scribing. He set a 3/4" X 6' solid aluminum marsh rod with a 3 1/4" stamped aluminum cap and the following B.T.s:

- | | | | |
|-----|--------------|---------|--------|
| 13" | Yellow Birch | N.66 W. | 31.19' |
| 10" | Cedar | S.86 E. | 23.98' |

B. Description of corner evidence found and/or method applied in restoring or reestablishing corner:

- | | | | |
|----|-----------------|---------|--------|
| 8" | Cedar | S.18 W. | 32.95' |
| 6' | Steel sign rail | N.82 E. | 2.19' |

Corner recorded in Gogebic County Liber 2, Page 655 on 12/10/84

Corner research on file with Gogebic County records.

Recovered the monument as described and the B.T.s as follows:

- | | | | |
|-----|-----------------|---------|-------------------|
| 14" | Yellow Birch | N.64 W. | 31.16' |
| 12" | Cedar | S.85 E. | 24.12' (new nail) |
| 10" | Cedar | S.17 W. | 32.94' |
| 6' | Steel sign rail | N.84 E. | 2.19' |


FIELD GROUP APPROVED
Richard L. Drahn 8/19/98
COURT REGISTERED

Evidence of all four original B.T.s still remain.

C. Description of monument for corner and accessories established to perpetuate locating the position of the corner:

New bearing tree referenced:

- | | | | |
|-----|-----------|---------|--------|
| 10" | Red Maple | N.09 W. | 29.95' |
|-----|-----------|---------|--------|

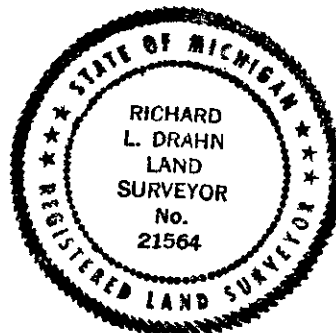

Signed by Richard L. Drahn

Date August 14, 1998

Surveyor's Michigan License No. 21564