

JAN 20 1999

LAND CORNER MONUMENTS


SECTION

T. 46 N., R. 45 W.

Index

BESSMER TOWNSHIP

State

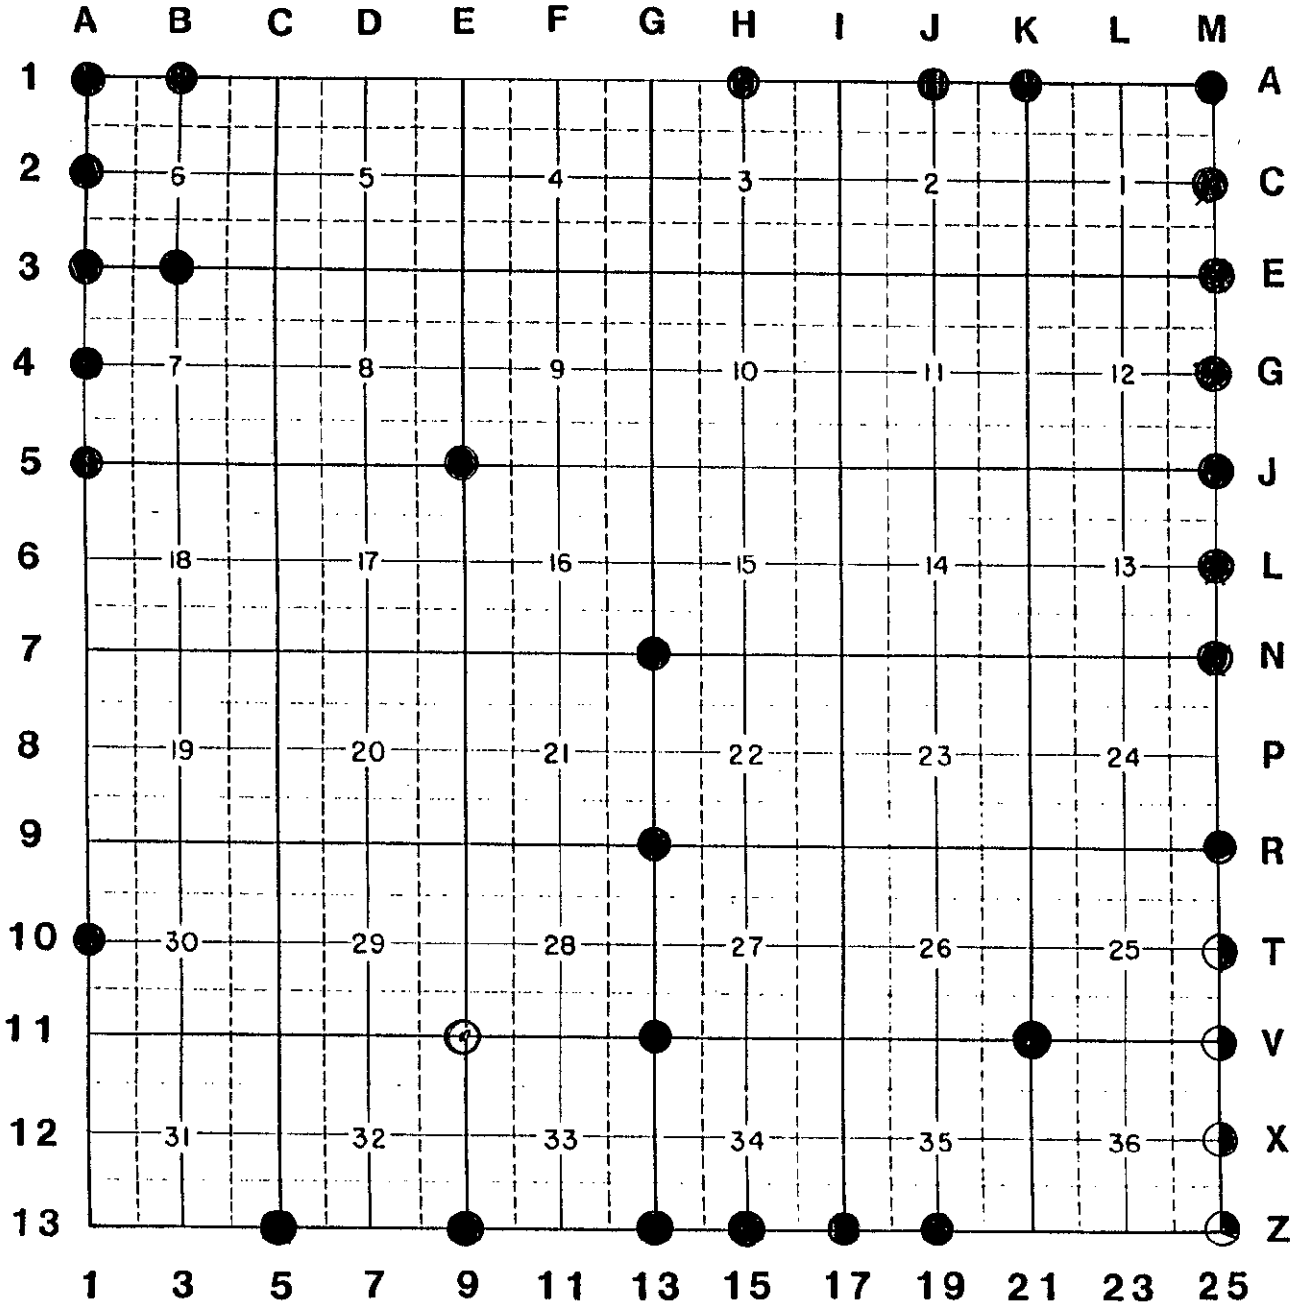

Index

AS OF 12/31/98

LEGEND

Federal

- GLO Corners researched
- ⊙ GLO Corners monumented, not approved
- ⊗ GLO Corners approved
- GLO Corners approved & reported to State

T. 46 N., R. 45 W.