

SURVEY & REMONUMENTATION

SEP 08 1998

SECTION

LAND CORNER RECORDATION CERTIFICATE
Filing Requirement of Act 74, Mich. P.A. 1970

For corners in

Located In: Gogebic (County) Corner Code # _____

1. Public Land Survey Section 6 T46NR 46W A-2 A-2
T46NR 47W M-2
 T ___ R ___
 T ___ R ___
 2. Property Controlling in Section S ___ T ___ R ___
 S ___ T ___ R ___
 3. Miscellaneous Property in Sec. S ___ T ___ R ___
 S ___ T ___ R ___

Register's Office }
Gogebic County } ss.

Received for record the 18TH day of JUNE
 A. D. 1998 at 1:15 o'clock
P m., and recorded in
 Liber 6 of CORNERS
 on page 408
Kamnah Collins Deput
 Register of Deeds

Register of Deeds Stamp & File Number

46-46

4. Lot No. _____, Recorded Plat _____
 5. Private Claims _____

1/4 Corner Sections 1 & 6, T46N, R47-46W


I, John R. Garske in a field survey on June 17, 1998 do hereby state that under requirements of P.A. 74, Michigan P.A. of 1970, the corner points mentioned in lines 1 and 2 above were in conformance with regulations and rules therefore as required in the current manual of survey instructions of the United States Department of the Interior, Bureau of Land Management or by a decree of a Court of Law and/or that the corner points mentioned in lines 3, 4 and 5 above were in conformance with the rules of the Michigan Board of Land Surveyors or by a Decree of a Court of Law; established, re-established, monumented, recovered, found as expressed below:

	A	B	C	D	E	F	G	H	I	J	K	L	M
1													
2	6		5		4		3		2		1		
3													
4	7		8		9		10		11		12		
5													
6	18		17		16		15		14		13		
7													
8	19		20		21		22		23		24		
9													
10	30		29		28		27		26		25		
11													
12	31		32		33		34		35		36		
13													

NOTE: Not more than 2 corners, all in the same town and range, may be recorded on this certificate.

A. Description of original monument and accessories and/or subsequent restoration:

Original Survey by John Burt, D.S. in 1847.
 He set a cedar post from which:
 Y. Birch 6" - N54°W - 31 links
 Cedar 12" - S82°E - 23 links

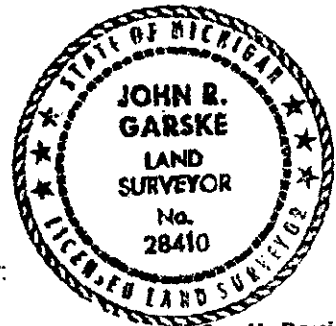

B. Description of corner evidence found and/or method applied in restoring or reestablishing corner:

The 1/4 corner falls at the centerline intersection of Helgren Road, running East and South Davis running North and South. An ancient fence line runs west. The Northeast corner of Section 1 is N00°-20'-01"E - 2645.20 feet and the Southeast of 1 is S00°-46'-49"W - 2627.99 feet.

(Research on file)

(see sketch on back)

PEER GROUP APPROVED
Richard P. DeWalt 6/17/98
 COUNTY REGISTER

C. Description of monument for corner and accessories established to perpetuate locating the position of the corner:

At the corner position I set a 5/8" x 12" iron rod with a 3 1/4" brass cap stamped to identify the corner, from which:
 I set 10 reference monuments both 2 1/2" x 30" long aluminum pipe monuments with 3 1/4" aluminum caps, stamped R.M. with distance to the corner.

R.M.1	N88°W	30.00 feet	Steel sign rail	1.54 feet
R.M.2	S45°E	55.00 feet	Steel sign rail	1.08 feet
Power Pole	N45°E	49.53 feet		
Power Pole	N50°W	39.44 feet		

Signed by John R Garske
 Surveyor's Michigan License No. 28410

Date 6/17/98

SURVEY &
REMONUMENTATION

SEP 08 1998

A-2

SECTION

