

SURVEY & REMONUMENTATION

SEP 08 1998

SECTION
For corners in

Gogebic
(County)

LAND CORNER RECORDATION CERTIFICATE
Filing Requirement of Act 74, Mich. P.A. 1970

Located in: _____ Corner Code # _____

- | | | | | |
|------------------------------------|-----------|------------|---------|-----|
| 1. Public Land Survey | Section 6 | T 46NR 46W | B-3 | A-3 |
| | | T 46NR 47W | M-3 | |
| | | T _____ | R _____ | |
| | | T _____ | R _____ | |
| 2. Property Controlling in Section | S _____ | T _____ | R _____ | |
| | S _____ | T _____ | R _____ | |
| 3. Miscellaneous Property in Sec. | S _____ | T _____ | R _____ | |
| | S _____ | T _____ | R _____ | |

Register's Office }
Gogebic County } ss.


Received for record the
18th day of JUNE
A. D. 1998 at 1:15 o'clock
P m., and recorded in
Liber 6 of CORNERS
page 409
Ramona L. Collins, Depu
Register of Deeds

Register of Deeds Stamp & File Number

4. Lot No. _____, Recorded Plat _____
5. Private Claims _____

Section Corner to 1, 12, 6 & 7, T46N, R47-46W


I, John R. Garske, in a field survey on June 17, 1998 do hereby state that under requirements of P.A. 74, Michigan P.A. of 1970, the corner points mentioned in lines 1 and 2 above were in conformance with regulations and rules therefore as required in the current manual of survey instructions of the United States Department of the Interior, Bureau of Land Management or by a decree of a Court of Law and for that the corner points mentioned in lines 3, 4 and 5 above were in conformance with the rules of the Michigan Board of Land Surveyors or by a Decree of a Court of Law, established, re-established, monumented, recovered, found as expressed below:

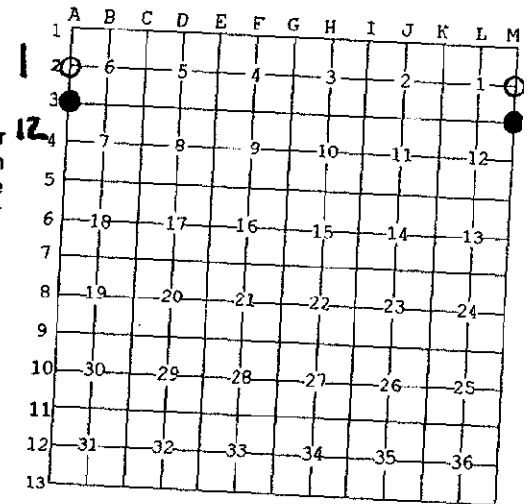

NOTE: Not more than 2 corners, all in the same town and range, may be recorded on this certificate.

A. Description of original monument and accessories and/or subsequent restoration:

Original Survey by John Burt, D.S. in 1847.
He set a Sugar post at the corner from which:
Y. Birch 16" - S57°E - 32 links
Hemlock 14" - N49°W - 32 links

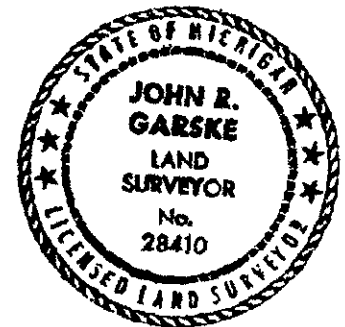

B. Description of corner evidence found and/or method applied in restoring or reestablishing corner:

I established the corner at the centerline intersection of South Davis Road and ancient fence lines running east and west from the road. This location fits well with other fence lines north and south of the corner. The 1/4 corner to 1 & 6 is N00°-46'-49"E - 2627.99 feet & the 1/4 corner to 12 & 7 is S00°-42'-44"W - 2638.76 feet.

(Research on file)

PEER GROUP APPROVED
Richard P. Dredman 6/17/98
COUNTY REGISTER

C. Description of monument for corner and accessories established to perpetuate locating the position of the corner:

At the corner position I set a 5/8" x 12" iron rod with a 3 1/4" dia. brass cap from which I established:
Twin Y. Birch 5" N44°W 44.38 feet
Sugar 14" S82°W 46.19 feet
Sugar 8" S40°W 72.37 feet
Reference Monument - 2 1/2" x 30" Alum. pipe with a 3 1/4" dia. alum. cap (stamped) S88°E-30.00 feet - Steel sign rail - 1.3 feet

Signed by John R. Garske
Surveyor's Michigan License No. 28410

Date 6/17/98