

SURVEY & REMONUMENTATION

SEP 08 1998

SECTION

LAND CORNER RECORDATION CERTIFICATE
Filing Requirement of Act 74, Mich. P.A. 1970

For corners in

Gogebic Located In: Corner Code #
(County)

1. Public Land Survey Section 12 ~~T46N R47W M-4~~
~~T46N R46W B-4 A-4~~
T___ R___
T___ R___

2. Property Controlling in Section S___ T___ R___
S___ T___ R___

3. Miscellaneous Property in Sec. S___ T___ R___
S___ T___ R___

4. Lot No. _____, Recorded Plat _____
5. Private Claims _____


1/4 Corner Sections 12 & 7, T47-46N, R46W

I, John R. Garske, in a field survey on June 17, 1998 do hereby state that under requirements of P.A. 74, Michigan P.A. of 1970, the corner points mentioned in lines 1 and 2 above were in conformance with regulations and rules therefore as required in the current manual of survey instructions of the United States Department of the Interior, Bureau of Land Management or by a decree of a Court of Law and /or that the corner points mentioned in lines 3, 4 and 5 above were in conformance with the rules of the Michigan Board of Land Surveyors or by a Decree of a Court of Law; established, re-established, monumented, recovered, found as expressed below:

NOTE: Not more than 2 corners, all in the same town and range, may be recorded on this certificate.

A. Description of original monument and accessories and/or subsequent restoration:

Original Survey by John Burt, D.S. in 1847.
He set a cedar post from which:
Hemlock 16" - N42°W - 17 links
Cedar 12" - N74°E - 6 links

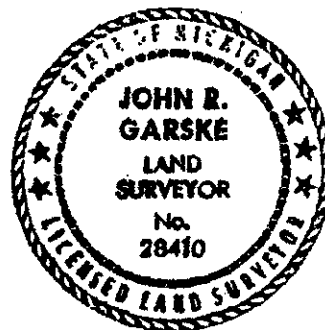

B. Description of corner evidence found and/or method applied in restoring or reestablishing corner:

At the corner position I found an ancient fence line running west and an old overgrown trail running North and South. This location lines up with the extension of the centerline of Salo Road from the east. The northeast corner of Section 12 is N00°-42'-44"E - 2638.76 feet and the southeast corner of 12 is S00°-47'-59"W - 2633.85 feet.

(Research on file)

C. Description of monument for corner and accessories established to perpetuate locating the position of the corner:

I set a 2 1/2" x 30" aluminum pipe monument with a stamped 3 1/4" dia. aluminum cap from which I established:

Maple	7"	N45°W	26.40 feet
Sugar	7"	S65°W	15.62 feet
Balsam	10"	S80°E	33.14 feet
Steel sign post		N45°E	1.88 feet

PEEB GROUP APPROVAL
Richard P. Nelson 6/17/98
COUNTY REGISTER

Signed by John R. Garske
Surveyor's Michigan License No. 28410

Date 6/17/98

Register's Office }
Gogebic County } ss.

Received for record the
18th day of JUNE
A. D. 1998 at 1:15 o'clock
P m., and recorded in
Liber 6 of CORNERS
on page 410
Ramona H. Collins, Dep
Register of Deeds

Register of Deeds Stamp & File Number

46-46

	A	B	C	D	E	F	G	H	I	J	K	L	M
1													
2		6		5		4		3		2		1	
3													
4													
5													
6		18		17		16		15		14		13	
7													
8		19		20		21		22		23		24	
9													
10		30		29		28		27		26		25	
11													
12		31		32		33		34		35		36	
13													