

DEC 15 1998

SECTION

LAND CORNER RECORDATION CERTIFICATE  
Filing Requirement of Act 74, Mich. P.A. 1970

Register's Office } ss.  
Gogebic County }

Received for record the  
30<sup>th</sup> day of OCTOBER  
A. D. 1998 at 9:05 o'clock  
A m., and recorded in  
Liber 7 of CORNERS  
on page 68  
Ramona Collins Deputy  
Register of Deeds

For corners in

<u>GOGEBIC</u> (County)	Located In:	Corner Code #
1. Public Land Survey	T <u>    </u> R <u>    </u>	
SECTION 24	<u>46N</u> R <u>47W</u> M-9	
	<u>46N</u> R <u>46W</u> A-9	
2. Property Controlling in Section	S <u>    </u> T <u>    </u> R <u>    </u>	
3. Miscellaneous Property in Sec.	S <u>    </u> T <u>    </u> R <u>    </u>	

Register of Deeds Stamp & File Number

4. Lot No. \_\_\_\_\_, Recorded Plat \_\_\_\_\_  
5. Private Claims \_\_\_\_\_

SECTION CORNER TO 24, 25, 19 & 30, T46N, R46-47W

I, JOHN R GARSKE, in a field survey on OCT. 21, 98, do hereby state that under requirements of P.A. 74, Michigan P.A. of 1970, the corner points mentioned in lines 1 and 2 above were in conformance with regulations and rules therefore as required in the current manual of survey instructions of the United States Department of the Interior, Bureau of Land Management or by a decree of a Court of Law and /or that the corner points mentioned in lines 3, 4 and 5 above were in conformance with the rules of the Michigan Board of Land Surveyors or by a Decree of a Court of Law; established, re-established, monumented, recovered, found as expressed below:

A	B	C	D	E	F	G	H	I	J	K	L	M
1												
2	6	5	4	3	2	1						
3												
4	7	8	9	10	11	12						
5												
6	18	17	16	15	14	13						
7												
8	19	20	21	22	23	24						
9												
10	30	29	28	27	26	25						
11												
12	31	32	33	34	35	36						
13												

NOTE: Not more than 2 corners, all in the same town and range, may be recorded on this certificate.

A. Description of original monument and accessories and/or subsequent restoration:

ORIGINAL TOWNSHIP SURVEY BY WILLIAM BURT, D.S. 1847.  
ORIGINAL CORNER: B. ASH POST  
ORIGINAL BEARING TREES:  
Y. BIRCH 18" N80°W 15 LINKS  
SPRUCE 14" S53°E 20 LINKS

B. Description of corner evidence found and/or method applied in restoring or reestablishing corner:

THE CORNER FALLS IN THE CENTER OF SOUTH DAVIS ROAD AND NO INFORMATION COULD BE FOUND IN THE PROXIMITY OF THE CORNER. I ESTABLISHED THE CORNER BY SINGLE PROPORTIONAL MEASUREMENT ON THE RANGE LINE IN ACCORDANCE WITH THE ORIGINAL GOVERNMENT NOTES BETWEEN KNOWN CORNER POSITIONS AS SHOWN ON THE SKETCH ON THE BACK.

(RESEARCH ON FILE)


FIELD GROUP REVISION  
Richard J. Dral 10/27/98  
COURT RE-ESTABLISHED

C. Description of monument for corner and accessories established to perpetuate locating the position of the corner:

I SET A 3 1/4" DIA. BRASS CAP STAMPED TO IDENTIFY THE CORNER ON A 12" X 5/8" DIA. IRON ROD AT THE CORNER POSITION BURIED 2" BELOW THE GRAVEL SURFACE OF SOUTH DAVIS RD. FROM WHICH:  
P. POLE S45°W 41.78 FEET  
10" SPRUCE N47°W 63.00 feet  
4" CEDAR S73°E 44.95 FEET  
REFERENCE MONUMENT CONSISTING OF A 2 1/2" ALUMINUM PIPE MONUMENT WITH A 3 1/4" DIA. STAMPED ALUMINUM CAP:  
WEST 47.00 FEET  
STEEL SIGN RAIL WEST 1.40 FEET FROM R.M.

Signed by John R Garske  
Surveyor's Michigan License No. 28410

Date 10-26-98

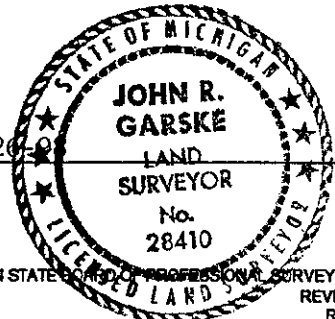

T 46 N  
 SIRILA ROAD — 24 — 1/4 COR. — MAKI ROAD  
 MONUMENTED CORNER

R 47 W

R 46 W

N 00° 10' 17" E  
 2641.97' (M)  
 2640.00' (R-GLO)

SOUTH DAVIS ROAD

SURVEY &  
 REMONUMENTATION

DEC 15 1998

SECTION

24 — 19  
 25 — 30

— SET BY  
 SINGLE PROPORTION

RANGE LINE

N 00° 10' 17" E  
 2641.97' (M)  
 2640.00' (R-GLO)

25 — 30

SET BY SINGLE  
 PROPORTION

1/4 COR.

N 00° 10' 17" E  
 2641.98'  
 2640.00' (R-GLO)

25 — 30  
 36 — 31

MONUMENTED  
 RECORDED  
 CORNER

