

SURVEY & MONUMENTATION

DEC 15 1998

LAND CORNER RECORDATION CERTIFICATE
Filing Requirement of Act 74, Mich. P.A. 1970

SECTION
For corners in

Register's Office } ss.
Gogebic County }

Received for record the
30TH day of OCTOBER
A. D. 1998 at 9:05 o'clock

A. m., and recorded in
Liber 7 of CORNERS
on page 69

Ramona Collins, Deputy
Register of Deeds

Register of Deeds Stamp & File Number

GOGEBIC (County)	Located In:	Corner Code #
1. Public Land Survey	SECTION 25	T 46N R 47W M-10 46N R 46W A-10
2. Property Controlling in Section	S	T R
3. Miscellaneous Property in Sec.	S	T R

4. Lot No. _____, Recorded Plat _____
5. Private Claims _____

1/4 CORNER, SECTIONS 25 & 30, T46N, R46-47W

I, JOHN R GARSKE, in a field survey on OCT. 21, 1998 do hereby state that under requirements of P.A. 74, Michigan P.A. of 1970, the corner points mentioned in lines 1 and 2 above were in conformance with regulations and rules therefore as required in the current manual of survey instructions of the United States Department of the Interior, Bureau of Land Management or by a decree of a Court of Law and /or that the corner points mentioned in lines 3, 4 and 5 above were in conformance with the rules of the Michigan Board of Land Surveyors or by a Decree of a Court of Law; established, re-established, monumented, recovered, found as expressed below:

NOTE: Not more than 2 corners, all in the same town and range, may be recorded on this certificate.

A	B	C	D	E	F	G	H	I	J	K	L	M
1												
2	6	5	4	3	2	1						
3												
4	7	8	9	10	11	12						
5												
6	18	17	16	15	14	13						
7												
8	19	20	21	22	23	24						
9												
10	30	29	28	27	26	25						
11												
12	31	32	33	34	35	36						
13												

A. Description of original monument and accessories and/or subsequent restoration:

ORIGINAL SURVEY BY WILLIAM BURT, D.S. 1847.
ORIGINAL CORNER: Y. BIRCH POST
ORIGINAL BEARING TREES:
Y. BIRCH 18" S75°W 29 LINKS
SUGAR 12" S78°E 30 LINKS

B. Description of corner evidence found and/or method applied in restoring or reestablishing corner:

I FOUND NO EVIDENCE OF THE CORNER POSITION WHICH FALLS IN THE CENTERLINE OF SOUTH DAVIS ROAD. I ESTABLISHED THE CORNER BY SINGLE PROPORTIONAL MEASUREMENT ON THE RANGE LINE BETWEEN KNOWN CORNER POSITIONS IN ACCORDANCE WITH THE ORIGINAL GOVERNMENT NOTES. THE SKETCH ON THE BACK SHOWS CORNERS SET AND DISTANCES USED IN PROPORTIONING.

PEER GROUP APPROVED
Richard K. Drahm 10/27/98
COURT'S RECORDS


(RESEARCH ON FILE)

C. Description of monument for corner and accessories established to perpetuate locating the position of the corner:

I SET A 3 1/4" DIA. BRASS CAP ON A 5/8" X 12" IRON ROD, STAMPED TO IDENTIFY THE CORNER, FROM WHICH I ESTABLISHED:
P. POLE N39°W 43.28 FEET
6" SPRUCE N76°E 39.93 FEET
P. POLE S15°E 87.17 FEET
REFERENCE MONUMENT - 2 1/2" X 30" ALUMINUM PIPE MONUMENT WITH A 3 1/4" DIA. STAMPED ALUMINUM CAP WEST 26.00 FEET
STEEL SIGN RAIL WEST 1.40 FEET FROM R.M.

Signed by *John R Garske*
Surveyor's Michigan License No. 28410

Date 10-26-98

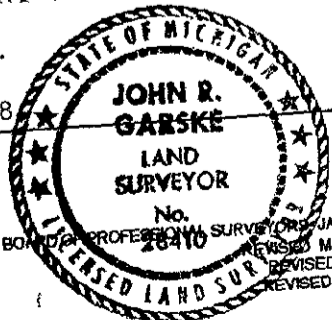

FORM APPROVED BY MICHIGAN STATE BOARD OF PROFESSIONAL SURVEYORS JAN. 28, 1971
REVISED MAY 14, 1975
REVISED JAN., 1983
REVISED OCT., 1995

T 46 N
SIIRILA ROAD — 24 19 — 1/4 COR. — MAKI ROAD

R 47 W

R 46 W

MONUMENTED CORNER

N 00° 10' 17" E
2641.97' (M)
2640.00' (R-GLO)
SOUTH DAVIS ROAD

24 19 — SET BY SINGLE PROPORTION
25 30

RANGE LINE

N 00° 10' 17" E
2641.97' (M)
2640.00' (R-GLO)

25 30 — SET BY SINGLE PROPORTION
1/4 COR.

N 03° 10' 17" E
2641.98'
2640.00' (R-GLO)

25 30 — MONUMENTED RECORDED CORNER
36 31

SURVEYOR
REMONUMER
DEC 15 1998
SECTION

