

SURVEY & REMONUMENTATION

LAND CORNER RECORDATION CERTIFICATE
Filing Requirement of Act 74, Mich. P.A. 1970

For corners in SEP 08 1998

Register's Office }
 Gogebic County } ss.

Received for record the
20TH day of AUGUST
 A. D. 1998 at 1:15 o'clock
P m., and recorded in
 Liber 7 of CORNERS
 on page 44

Ramona Collins Deputy
 Register of Deeds

Gogebic SECTION Located In: Corner Code #
 (County)
 ERWIN TOWNSHIP
 1. Public Land Survey T 46 N R 47 W M-11
~~T 46 N R 46 W~~ ~~A-11~~
 T ___ R ___
 T ___ R ___
 T ___ R ___
 2. Property Controlling S ___ T ___ R ___
 in Section S ___ T ___ R ___
 3. Miscellaneous S ___ T ___ R ___
 Property in Sec. S ___ T ___ R ___

4. Lot No. _____, Recorded Plat _____
 5. Private Claims _____

SECTION CORNER TO 25 & 36 AND 30 & 31; T 46 N, R 47 W, R 46 W RESPECTIVELY

I, JOHN R. GARSKE, in a field survey on JUNE 17, 19 98 do hereby state that under requirements of P.A. 74, Michigan P.A. of 1970, the corner points mentioned in lines 1 and 2 above were in conformance with regulations and rules therefore as required in the current manual of survey instructions of the United States Department of the Interior, Bureau of Land Management or by a decree of a Court of Law and for that the corner points mentioned in lines 3, 4 and 5 above were in conformance with the rules of the Michigan Board of Land Surveyors or by a Decree of a Court of Law, established, re-established, monumented, recovered, found as expressed below.

NOTE: Not more than 2 corners, all in the same town and range, may be recorded on this certificate

A	B	C	D	E	F	G	H	I	J	K	L	M
1												
2	6		5		4		3		2		1	
3												
4	7		8		9		10		11		12	
5												
6	13		17		16		15		14		13	
7												
8	15		20		21		22		23		24	
9												
10	30		29		28		27		26		25	
11												
12	31		32		33		34		35		36	
13												

A. Description of original monument and accessories and/or subsequent restoration:

ORIGINAL CORNER ESTABLISHED BY WILLIAM A. BURT - SEPT., 1847
 ORIGINAL CORNER: WOOD POST
 ORIGINAL BEARING TREES:
 CEDAR 14" S 42 ° W 15 LINKS (9.90 feet)
 CEDAR 9" N 59 ° E 12 LINKS (7.92 feet)

PEER GROUP APPROVED
Richard P. Dean 8/19/98
 COUNTY REGISTER

B. Description of corner evidence found and/or method applied in restoring or reestablishing corner:

NO ORIGINAL EVIDENCE WAS FOUND.
 CENTERLINE OF GORD ROAD AND CENTERLINE OF SOUTH DAVIS ROAD WERE THE ONLY NOTICABLE EVIDENCE AS TO THE LOCATION OF THE CORNER. ALL THE AVAILABLE EVIDENCE POINTED TO THIS INTERSECTION AS THE PROPER CORNER LOCATION OF THIS GOV'T CORNER.


RECORD RESEARCH ON FILE (see SKETCH ON BACK)

C. Description of monument for corner and accessories established to perpetuate locating the position of the corner:

AT THE CORNER LOCATION I SET A 10" X 5/8" IRON ROD WITH A STAMPED BRASS CAP, FROM WHICH I ESTABLISHED THE FOLLOWING NEW

BLAZED AND SCRIBED BEARING TREES/ WITNESSES:
 (all measurements taken to nail set in tree)

REF. MON. W/CAP	2 1/2"	N 58° E	45.00 feet
CEDAR	9"	N 40° W	54.80 feet
SPLIT CEDAR	6"	S 82° E	56.57 feet
POWER POLE		S 55° W	26.21 feet

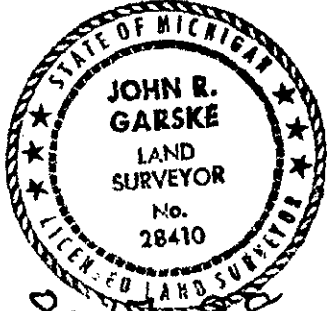

Signed by John R. Garske Date 8-17-98
 Surveyor's Michigan License No. P.S. 28410

SURVEY &
REMONUMENTATION

SEP 08 1998

SECTION

