

**SURVEY & REMONUMENTATION**

DEC 15 1998

**LAND CORNER RECORDATION CERTIFICATE**  
Filing Requirement of Act 74, Mich. P.A. 1970

**SECTION**

For corners in

<u>GOGEBIC</u> (County)	Located In:	Corner Code #
1. Public Land Survey	T ___ R ___	_____
SECTION 36	T46N R 47W M-12	_____
	<u>T46N R 46W A-12</u>	_____
	T ___ R ___	_____
2. Property Controlling in Section	S ___ T ___ R ___	_____
	S ___ T ___ R ___	_____
3. Miscellaneous Property in Sec.	S ___ T ___ R ___	_____
	S ___ T ___ R ___	_____

Register's Office }  
Gogebic County } ss.

Received for record the  
30<sup>th</sup> day of OCTOBER  
A. D. 1998 at 9:05 o'clock  
A m., and recorded in  
Liber 7 of CORNERS  
on page 70  
Ramona Collins, Deputy  
Register of Deeds

Register of Deeds Stamp & File Number

4. Lot No. \_\_\_\_\_, Recorded Plat \_\_\_\_\_  
5. Private Claims \_\_\_\_\_

**1/4 CORNER SECTIONS 36 & 31, T46N, R46-47W**

I, JOHN R GARSKE, in a field survey on OCT. 21, 1998 do hereby state that under requirements of P.A. 74, Michigan P.A. of 1970, the corner points mentioned in lines 1 and 2 above were in conformance with regulations and rules therefore as required in the current manual of survey instructions of the United States Department of the Interior, Bureau of Land Management or by a decree of a Court of Law and /or that the corner points mentioned in lines 3, 4 and 5 above were in conformance with the rules of the Michigan Board of Land Surveyors or by a Decree of a Court of Law; established, re-established, monumented, recovered, found as expressed below:

NOTE: Not more than 2 corners, all in the same town and range, may be recorded on this certificate.

A	B	C	D	E	F	G	H	I	J	K	L	M
1												
2	6	5	4	3	2	1						
3												
4	7	8	9	10	11	12						
5												
6	18	17	16	15	14	13						
7												
8	19	20	21	22	23	24						
9												
10	30	29	28	27	26	25						
11												
12	31	32	33	34	35	36						
13												

A. Description of original monument and accessories and/or subsequent restoration:

**ORIGINAL SURVEY BY WILLIAM BURT, D.S. IN SEPT. 1847.**  
**ORIGINAL CORNER: CEDAR POST**  
**ORIGINAL BEARING TREES:**  
CEDAR 6" N68°W 20 LINKS  
DO 14" S17E 35 LINKS

B. Description of corner evidence found and/or method applied in restoring or reestablishing corner:

**I MADE A THROUGH SEARCH OF THE CALCULATED POSITION OF THE CORNER AND FOUND NO EVIDENCE OF IT'S LOCATION. I ESTABLISHED THE CORNER BY SINGLE PROPORTIONAL MEASUREMENT ON THE RANGE LINE BETWEEN THE CLOSING CORNER ON THE STATE LINE AND THE SECTION CORNER TO THE NORTH IN ACCORDANCE WITH THE ORIGINAL GOVERNMENT NOTES.**

(RESEARCH ON FILE)

(SEE SKETCH ON BACK)

C. Description of monument for corner and accessories established to perpetuate locating the position of the corner:


**PEER GROUP APPROVED**  
Richard L. Drach 10/29/98  
COUNTY REGISTER

**I SET A 2 1/4" DIA. BY 30" LONG ALUMINUM PIPE MONUMENT WITH A 3 1/4" ALUMINUM CAP, STAMPED TO IDENTIFY THE CORNER, FROM WHICH I ESTABLISHED:**

4" SUGAR MAPLE N21°W 18.50 FEET  
6" SUGAR MAPLE S20°W 18.50 FEET  
6" SUGAR MAPLE N72°W 4.18 FEET  
STEEL SIGN RAIL S45°E 1.55 FEET

Signed by John R Garske  
Surveyor's Michigan License No. 28410


Date 10-26-98

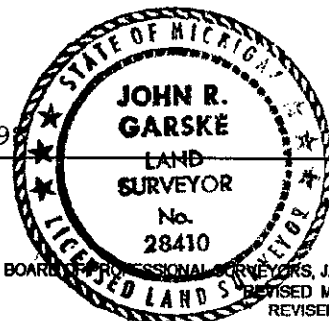

FORM APPROVED BY MICHIGAN STATE BOARD OF PROFESSIONAL SURVEYORS, JAN. 28, 1971  
REVISED MAY 14, 1975  
REVISED JAN., 1983  
REVISED OCT., 1985

UNDERWOOD GRADE 25 30 MONUMENTED RECORDED CORNER 36 31

R 47 W R 46 W

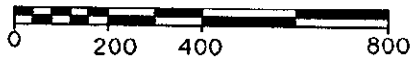

RANGE LINE

SURVEY & REMONUMENTATION

DEC 15 1998

SECTION

N 00° 33' 06" E  
2630.04' (M)  
2640.00' (R-GLO)

36 31 1/4 COR.  
ESTABLISHED BY SINGLE PROPORTION

N 00° 33' 06" E  
1578.02' (M)  
1584.00' (R-GLO)

CLOSING CORNER ESTABLISHED ON STATE LINE BY SINGLE PROPORTION

MONTREAL RIVER  
MILE MARKER NO. 0  
FOUND. CONC. MON'T. (REC.)  
APPROX. LOCATION

MICHIGAN  
WISCONSIN  
S 74° 29' 49" E 1522.62' (R-BURT)(23.07 CH.)  
1523.16' (M)

S 74° 29' 49" E 2652.84' (M)  
S 74° 27' E (R) 2640' (R-BURT-1847)  
2651.9' (HARRINGTON-1928)

MICHIGAN  
WISCONSIN  
STATE LINE  
S 74° 29' 49" E 1129.66' (M)

MILE MARKER NO. 1/2  
FOUND. CONC. MON'T (REC)