

SURVEY & REMONUMENTATION

OCT 03 1996

COMMISSION

LAND CORNER RECORDATION CERTIFICATE

Filing Requirement of Act 74, Mich. P.A. 1970

For corners in Gogebic (County) Located In: Corner Code #

- 1. Public Land Survey Section 31

T 47N	R 46W	B-13
T 45N	R 46W	B-1
T 46N	R	
T	R	
- 2. Property Controlling in Section

S	T	R
S	T	R
- 3. Miscellaneous Property in Section

S	T	R
S	T	R

Register's Office }
Gogebic County } ss.

Received for record the 16TH day of AUGUST A. D. 1996 at 10:45 o'clock A M., and recorded in Liber 6 of CORNERS on page 6
Amona Collins Deputy
Register of Deeds

Register of Deeds Stamp & File Number

- 4. Lot No. _____, Recorded Plat _____
- 5. Private Claims _____

One quarter section corner common to Sections 31 and 6, T47N, R46W.

I, John R. Garske, in a field survey on July 17, 1996, do hereby certify that under requirements of P.A. 74, Michigan P.A. of 1970, the corner points mentioned in lines 1 and 2 above were in conformance with regulations and rules therefore as required in the current manual of survey instructions of the United States Department of the Interior, Bureau of Land Management or by a decree of a Court of Law and/or that the corner points mentioned in lines 3, 4 and 5 above were in conformance with the rules of the Michigan Board of Professional Surveyors or by a Decree of a Court of Law; established, re-established, monumented, re-monumented, recovered, found as expressed below:

NOTE: Not more than 4 corners, all in the same town and range, may be recorded on this certificate.


A. Description of original monument and accessories and/or subsequent restoration:

- On September 3, 1847, William Burt, U.S. Deputy Surveyor, set a post with a: 12" hemlock - N28°E - 46 links (30.36') 30" Y. birch - N58°W - 6 links (3.96')

B. Description of corner evidence found and/or method applied in restoring or reestablishing corner:

I established the corner position at the centerline intersection of Pioneer Road and East End Road and the centerline of an old farm lane running north. A distance of 2625.79 feet was measured east to a N-S, E-W fenceline line intersection and a distance of 2474.79 feet (2475 GLO) west was measured to the monumented corner on the Town line. Fence lines east and west at farm "40 Lincs" also check well with this corner position.

Record Research on file.

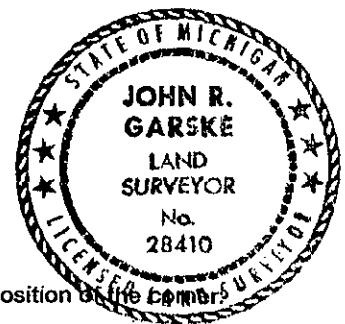

C. Description of monument for corner and accessories established to perpetuate locating the position of the corner:

The corner position is marked by a 3 1/4" diameter brass cap atop a 5/8" x 24" rebar encased in concrete. The cap is stamped as follows: County Remonumentation, T47N, R46W, T46N, 1/4, S-31, S-6, 1996, R.L.S. 28410. The following bearing trees and reference objects were established:

- 2 1/2" diameter x 30" aluminum pipe with 3 1/4" diameter aluminum cap stamped: County Remonumentation, T47N, R46W, R.M., 1/4, S-31, S-6, T46N, 1996, R.L.S. 28410, N35°W, 45.31' with steel sign rail 1.60' away.
- Power pole - S66°W - 65.05 feet
- Guy pole - N60°W - 71.15 feet
- 8" cherry - N55°E - 75.41 feet

PEER GROUP APPROVED
Richard R. Dahn 8/14/96
COUNTY _____

Signed by John R. Garske
Surveyor's Michigan License No. 28410

Date 8-4-96

FORM APPROVED BY MICHIGAN STATE BOARD OF PROFESSIONAL SURVEYORS, JAN. 28, 1971
REVISED MAY 14, 1975
REVISED JAN., 1983