

**LAND CORNER RECORDATION CERTIFICATE**  
Filing Requirement of Act 74, Mich. P.A. 1970

Register's office }  
Gogebic County } ss.

Received for record the

JUNE 22 day of JUNE

A. D. 192000 at 1:20 o'clock

P m., and recorded in

Libr 7 of CORNERS

on page 391  
*Cheryl Ruppel, Dep.*  
Register of Deeds

Register of Deeds Stamp & File Number

For corners in

Gogebic Located In: Corner Code #  
(County)

1. Public Land Survey T46 N R46W. C-11  
T R  
T R SURVEY &  
T R MONUMENTATION  
2. Property Controlling S T R  
in Section S T R  
3. Miscellaneous S T R JAN 05 2001  
Property in Sec. S T R

SECTION

4. Lot No. \_\_\_\_\_, Recorded Plat \_\_\_\_\_  
5. Private Claims \_\_\_\_\_

Section Corner 29, 30, 31 & 32; T.46 N., R.46 W.

I, Richard L. Drahn, in a field survey on May 31, 2000 do hereby state that under requirements of P.A. 74, Michigan P.A. of 1970, the corner points mentioned in lines 1 and 2 above were in conformance with regulations and rules therefore as required in the current manual of survey instructions of the United States Department of the Interior, Bureau of Land Management or by a decree of a Court of Law and /or that the corner points mentioned in lines 3, 4 and 5 above were in conformance with the rules of the Michigan Board of Land Surveyors or by a Decree of a Court of Law; established, re-established, monumented, recovered, found as expressed below:

A	B	C	D	E	F	G	H	I	J	K	L	M
1												
2	6	5	4	3	2	1						
3												
4	7	8	9	10	11	12						
5												
6	18	17	16	15	14	13						
7												
8	19	20	21	22	23	24						
9												
10	30	29	28	27	26	25						
11												
12	31	32	33	34	35	36						
13												

**NOTE:** Not more than 2 corners, all in the same town and range, may be recorded on this certificate.

A. Description of original monument and accessories and/or subsequent restoration:  
Original corner established by Austin Burt on 6/23/1851. Original bearing trees:  
Cedar 12" S.40° E. 31 links (20.46')  
Cedar 12" N.35° W. 25 links (16.50')

J. Meredith on 5/23/35 found a Cedar post and scribed 10" Cedar witness tree laying N.44 W. 18 ft. From post. He placed a tag on a 10" Cedar, post is S.44 E. 18 feet.

B. Description of corner evidence found and/or method applied in restoring or reestablishing corner:

I restored the corner position at record bearing and distance from the remains of the two original B.T.s. The first is a 14-16" very badly decayed Cedar windfall. The second one is now a large shallow windthrown depression. Cedars in swamp have been logged, taking out Merediths' scribed W.T. and post. 1935 era blazes recovered on a 14" downed and decayed White Pine 43 ft. West, and a 12-16" broken Cedar stub South 17 ft. A 1950s era Cedar post lays S.19° E., 32.5 ft. A Downed Balsam picket lays N.05° E. 52 ft. Swamp calls north, west and east are in accordance with the field notes of the original Government Survey.


Corner research on file with Gogebic County records.

C. Description of monument for corner and accessories established to perpetuate locating the position of the corner:

At the corner position I set a 3/4" X 48" solid aluminum rod monument with a 3 1/4" stamped aluminum cap and the following new B.T.s (all measurements taken to a nail in side of tree)

Yellow Birch	8"	N.55° E.	3.49'
Cedar	5"	S.05° W.	24.33'
Yellow Birch	5"	N.77° W.	24.85'
Steel sign rail	6'	S.48° E.	2.43'

PEER GROUP APPROVED  
*Richard L. Drahn 6/21/00*  
CORNER REESTABLISHED

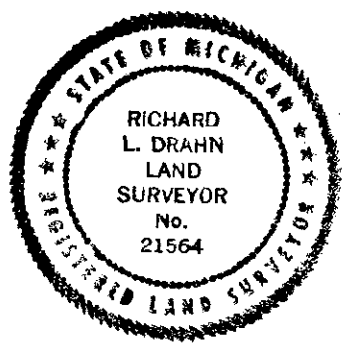

Signed by Richard L. Drahn Date June 14, 2000

Surveyor's Michigan License No. 21564

FORM APPROVED BY MICHIGAN STATE BOARD OF PROFESSIONAL SURVEYORS, JAN. 28, 1971  
REVISED MAY 14, 1978  
REVISED JAN. 1983  
REVISED OCT., 1995