

MAR 02 2000

SECTION

LAND CORNER RECORDATION CERTIFICATE
Filing Requirement of Act 74, Mich. P.A. 1970

For corners in

<u>Gogebic</u> (County)	Located In:	Corner Code #
1. Public Land Survey	T <u>46N</u> R <u>46 W.</u>	<u>E-7</u>
	T _____ R _____	_____
	T _____ R _____	_____
	T _____ R _____	_____
2. Property Controlling in Section	S _____ T _____ R _____	_____
	S _____ T _____ R _____	_____
3. Miscellaneous Property in Sec.	S _____ T _____ R _____	_____
	S _____ T _____ R _____	_____

Register's Office }
Gogebic County } ss.


Received for record the
10TH day of NOVEMBER
A. D. 1999 at 11:25 o'clock
A m., and recorded in
Liber 7 of CORNERS
on page 265
Ramona Collins Deputy
Register of Deeds

Register of Deeds Stamp & File Number

4. Lot No. _____, Recorded Plat _____
5. Private Claims _____

Section Corner 16, 17, 20 & 21; T.46 N., R.46 W.

I, Richard L. Drahn, in a field survey on November 8, 1999 do hereby state that under requirements of P.A. 74, Michigan P.A. of 1970, the corner points mentioned in lines 1 and 2 above were in conformance with regulations and rules therefore as required in the current manual of survey instructions of the United States Department of the Interior, Bureau of Land Management or by a decree of a Court of Law and /or that the corner points mentioned in lines 3, 4 and 5 above were in conformance with the rules of the Michigan Board of Land Surveyors or by a Decree of a Court of Law; established, re-established, monumented, recovered, found as expressed below:

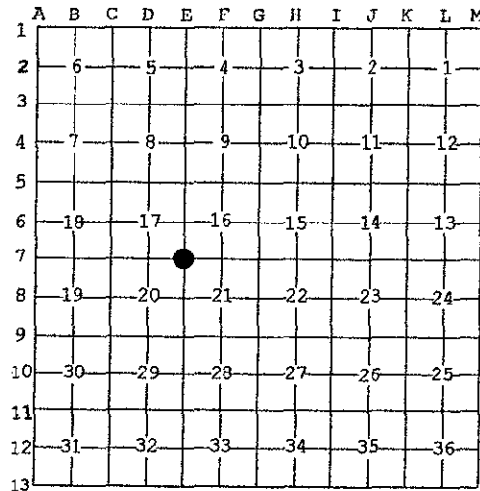

NOTE: Not more than 2 corners, all in the same town and range, may be recorded on this certificate.

A. Description of original monument and accessories and/or subsequent restoration:

Original corner established by Austin Burt. Original bearing trees:
Y. Birch 14" S.27° W. 37 links (24.42')
Cedar 16' N.36° E. 9 links (5.94')

Campbell & Barron, on 6/3/35 recovered both B.T.s still scribed (Y.Birch was a stub). They set a location poster on the east side of a 10" balsam. A balsam picket lay 9 paces east and 1 pace south.

B. Description of corner evidence found and/or method applied in restoring or reestablishing corner:

I restored the corner position at record bearing and distance from the remains of the two original bearing trees. The first is a large Yellow Birch stump, decayed to well below ground line. The second one is now a badly decayed downed Cedar, bottom portions rotted away. I recovered the 1935 location poster on the ground bearing N.76° W. 26.7 ft. From the original corner position. The 1.22 chain distance east to "leave swamp, N-S" checks.

Corner research on file with Gogebic County records.

C. Description of monument for corner and accessories established to perpetuate locating the position of the corner:

At the corner position I set a 3/4" X 4' aluminum rod monument with a 3 1/4" stamped aluminum cap and the following new B.T.s (all measurements taken to a nail in side of tree)

Cedar 15" N.06° E. 30.41'
Sugar Maple 5" S.62° E. 25.83'
Sugar Maple 4" N.84° W. 11.75'
Steel sign rail 6' N.49° W. 2.00'

DEED GROUP APPROVED
Richard L. Drahn 11/9/99
COUNTY RECOMMENDATION



Signed by Richard L. Drahn Date November 8, 1999

Surveyor's Michigan License No. 21564
USFS N-9

FORM APPROVED BY MICHIGAN STATE BOARD OF PROFESSIONAL SURVEYORS, JAN. 28, 1971

REVISED MAY 14, 1976
REVISED JAN., 1983

REVISED OCT., 1996