MAR 0 2 2000

SECTION

LAND CORNER RECORDATION CERTIFICATE
Filing Requirement of Act 74, Mich. P.A. 1970

Register's Office } ss.
Gogebic County }

Received for record the 26TH day of AUGUST A. D. 1999 at 1:35 o'clock P m., and recorded in Liber 7 of CORNERS on page 225

Ramona Collins Deputy
Register of Deeds

Register of Deeds Stamp & File Number

For corners in Gogebic (County)

	Located In:	Corner Code #
1. Public Land Survey	T46N R 46W	F-3
	T___ R___	
	T___ R___	
	T___ R___	
2. Property Controlling in Section	S___ T___ R___	
	S___ T___ R___	
3. Miscellaneous Property in Sec.	S___ T___ R___	
	S___ T___ R___	

4. Lot No. _____, Recorded Plat _____
5. Private Claims _____

1/4 corner sections 4 & 9, T46N,R46W

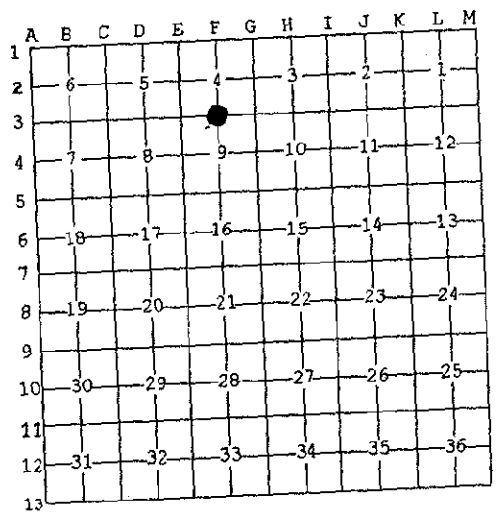

I, John P. Goss, in a field survey on Aug. 3, 1999 do hereby state that under requirements of P.A. 74, Michigan P.A. of 1970, the corner points mentioned in lines 1 and 2 above were in conformance with regulations and rules therefore as required in the current manual of survey instructions of the United States Department of the Interior, Bureau of Land Management or by a decree of a Court of Law and /or that the corner points mentioned in lines 3, 4 and 5 above were in conformance with the rules of the Michigan Board of Land Surveyors or by a Decree of a Court of Law; established, re-established, monumented, recovered, found as expressed below:

NOTE: Not more than 2 corners, all in the same town and range, may be recorded on this certificate.

A. Description of original monument and accessories and/or subsequent restoration:
Corner established by Austin Burt on July 3, 1851. set post.
Original bearing trees: Cedar 8" S 18° W 5 links (3.30 ft.)
Spruce 14" N 15° E 76 links (50.16 ft.)

B. Description of corner evidence found and/or method applied in restoring or reestablishing corner:
No evidence of original bearing trees found due to road construction. Corner restored at the interest of the centerline of a East/West and North/South Roads. At the corner position found a P.K. Nail. I accept the P.K. nail as the best location as it checked out to the creek call to the West and river call to the East in accordance with the field noted of the original Government Survey.

PEER GROUP APPROVAL
Richard L. Drahn 8/24/99
COUNTY REPRESENTATIVE

C. Description of monument for corner and accessories established to perpetuate locating the position of the corner:
I replace the P.K. Nail with a ½" by 9" rebar with a 2" brass cap marked T.46 N., R.46 W.; 1/4; S-4, S-9; 1999; P.S. 23509. I established the following bearing trees and reference objects:

P.Pole # 3-56/95	S 26° E	45.88'
7" Spruce	N 20° E	65.55'
9" Cedar	S 08° E	114.16'

Reference Monument consisting of 2½" x 30" Aluminum monument with 3¼" aluminum cap stamped to indicated corner position:
N 35° W - 42.00' with 6' steel rail & sign - 1.04' to face

STATE OF MICHIGAN
JOHN P. GOSS
LAND SURVEYOR
No. 23509
REGISTERED LAND SURVEYOR

Signed by John P Goss
Date Aug. 3, 1999
Surveyor's Michigan License No. 23509
USFS. # E-11

FORM APPROVED BY MICHIGAN STATE BOARD OF PROFESSIONAL SURVEYORS, JAN. 28, 1971
REVISED MAY 14,1975
REVISED JAN., 1983
REVISED OCT., 1995